

Form 51--5M--7-39--Palace


Rice

Section 33 Township 19 Range 9-W

Well No. #2 Purcell

Company Skelly

NORTH Campbell Pool

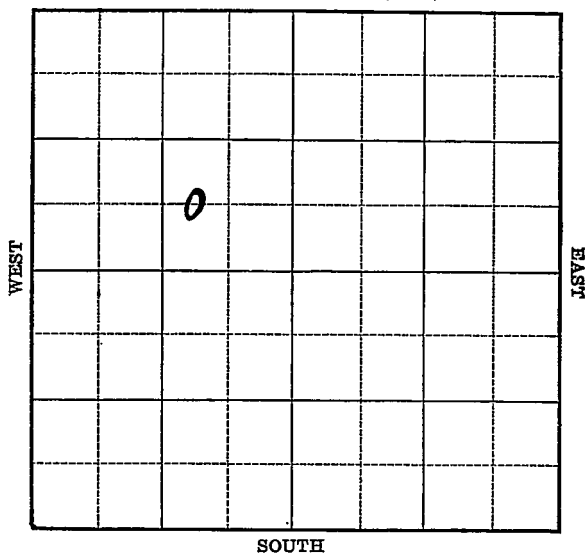

KANSAS

Rice


Sec. 33 Twp. 19 R. 9-WWell No. #2 Purcell FarmSkelly

Company

(Campbell)

 Ft. from N. Line660 Ft. from S. Line990 Ft. from E. Line Ft. from W. Line

Elev. 1693

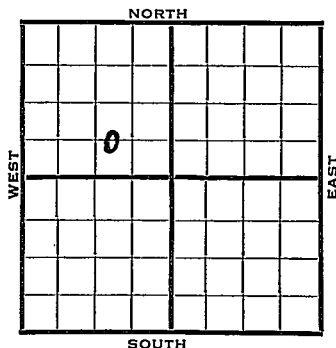

1940

REPORT

5/15

Rotary.

5/23

8" - 211' Drlg. 1070'

5/29

Drlg. 2763'

6/6

Lansing 2900' Arb. 3212-16' TD

5" - 3213' 600' oil 11 hours.

6/13

T.D. 3218' 900' oil 17 hrs.

500 acid. 570 acid. 1500 acid.

Core 3218-22½' T.D. 1000 acid.

Testing.

6/19

Arb. 3212'

5" - 3213'

T.D. 3222½'

3570 acid.

Potential 378 bbls., pump.

COMPLETED

Map No. 49 Sec. 33 Twp. 19 R. 9WWell No. 2 PurcellSkelly

Company

Contractor

FIRST REPORT

C W L SE NW

_____ Ft. from N. Line

660 Ft. from S. Line990 Ft. from E. Line

_____ Ft. from W. Line

SECTION PLAT

	0 -		

CAMPBELL POOL

Location _____

Rig up _____

Drilling and Remarks:
Rotary**RECORD**

Cased _____ in., _____ ft.

Sand _____

Gas _____

Oil _____

Total Depth _____

PRODUCTION

1st 24 hrs. Nat. _____

1st 24 hrs. after shot _____

Gas _____ Cu. Ft.

Dry Hole _____

Abandoned _____

Date

MAY 15 1940 19S. J. LEWIS Scout

Map No. 49 Sec. 33 Twp. 19 R. 9WWell No. 2 PurcellSkelly Company

Contractor

COMPLETED

C W L SE NW

 Ft. from N. Line660 Ft. from S. Line990 Ft. from E. Line Ft. from W. Line

SECTION PLAT

	0		

CAMPBELL POOL

Location Rig up

Drilling and Remarks:

*Cor 8212**5" C 3213**3570 acid**Pump 378 P.O.*

RECORD

Cased in., ft.Sand Gas Oil Total Depth 3222 1/2

PRODUCTION

1st 24 hrs. Nat. 1st 24 hrs. after shot Gas Cu. Ft.Dry Hole Abandoned

Date

JUN 19 1940 19

S. J. LEWIS Scout