

KANSAS


Rice

Section 33 Township 19 Range 9-W

Well No. 1 Purcell

Company Skelly Oil

Campbell Pool

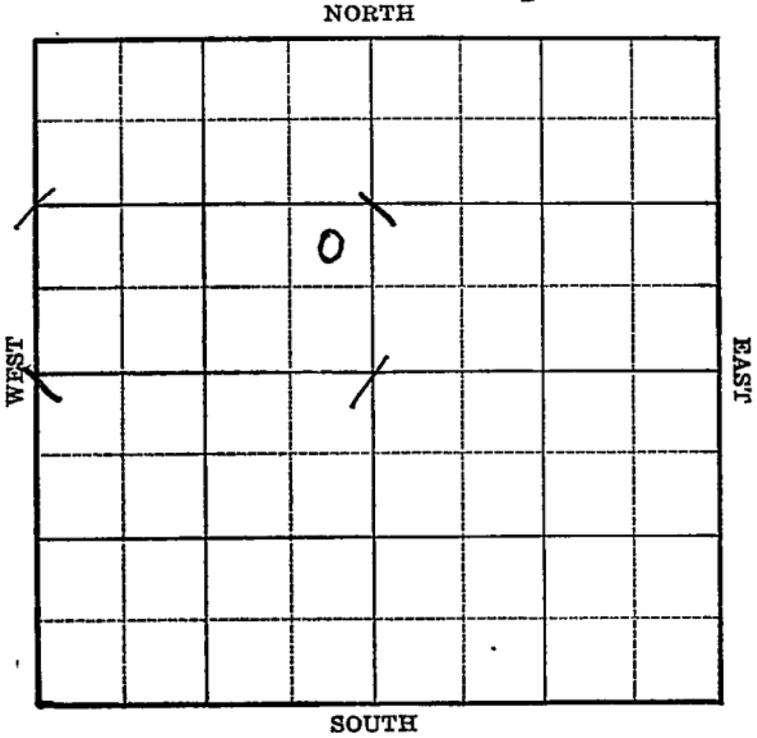

Sec. 33 Twp. 19 R. 9-W

Well No. #1 Purcell Farm

Skelly Oil Company

(Campbell)


\_\_\_\_\_ Ft. from N. Line

990 Ft. from S. Line

330 Ft. from E. Line

\_\_\_\_\_ Ft. from W. Line

Elev. 1691

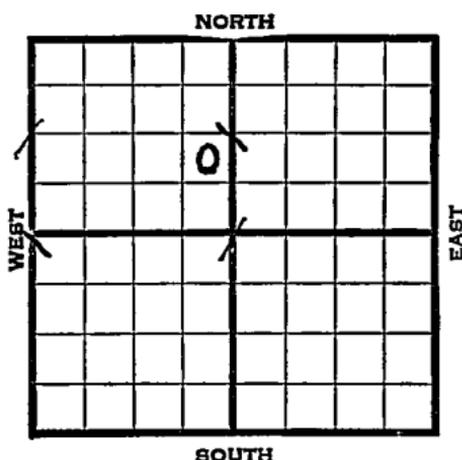

| 1939 | REPORT                        |
|------|-------------------------------|
| 5/17 | Location                      |
| 5/26 | Rotary rig.                   |
| 6/1  | 10" - 220' WOC.               |
| 6/8  | Drlg. 3035'                   |
| 6/16 | Lans. 2820' Arb. 3190'        |
|      | 7" - 3191' T.D. 3215'         |
|      | Swab 60 oil 2½ hours.         |
|      | 2000 acid. No test.           |
| 6/21 | Arb. 3190'                    |
|      | T.D. 3215'                    |
|      | 7" - 3191'                    |
|      | 2000 acid.                    |
|      | Potential 1047 bbls. pumping. |
|      | <b>COMPLETED</b>              |
|      |                               |
|      |                               |
|      |                               |
|      |                               |

Map No. 44 Sec. 33 Twp. 19 R. 9WWell No. 1 PurcellSkelly Oil Company

Contractor

## FIRST REPORT

NE SE NW

Ft. from N. Line

990

Ft. from S. Line

330

Ft. from E. Line

Ft. from W. Line

## SECTION PLAT

|  |  |  |  |
|--|--|--|--|
|  |  |  |  |
|  |  |  |  |
|  |  |  |  |
|  |  |  |  |

CAMPBELL POOL

Location X

Rig up \_\_\_\_\_

Drilling and Remarks:

## RECORD

Cased \_\_\_\_\_ in., \_\_\_\_\_ ft.

Sand \_\_\_\_\_

Gas \_\_\_\_\_

Oil \_\_\_\_\_

Total Depth \_\_\_\_\_

## PRODUCTION

1st 24 hrs. Nat. \_\_\_\_\_

1st 24 hrs. after shot \_\_\_\_\_

Gas \_\_\_\_\_ Cu. Ft.

Dry Hole \_\_\_\_\_

Abandoned \_\_\_\_\_

Date

MAY 17 1939 19

S. J. LEWIS Scout

Rice

KANSAS

Map No. \_\_\_\_\_ Sec. 33 Twp. 19 R. 9W

Well No. 1 Purcell

Skelly Oil Company

Contractor

COMPLETED

SECTION PLAT


NE SE NW

\_\_\_\_\_ Ft. from N. Line

990 Ft. from S. Line

330 Ft. from E. Line

\_\_\_\_\_ Ft. from W. Line

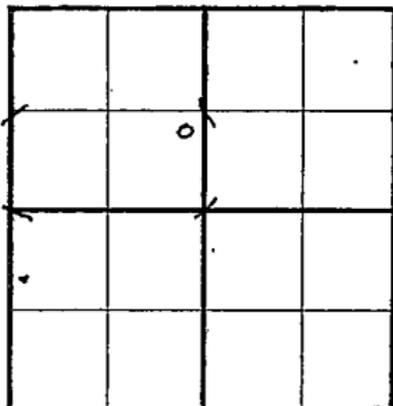

CAMPBELL POOL

Location \_\_\_\_\_

RECORD

Rig up \_\_\_\_\_

Cased \_\_\_\_\_ in., \_\_\_\_\_ ft.

Drilling and Remarks:

Sand \_\_\_\_\_

*Or 83190*

Gas \_\_\_\_\_

*7" @ 3191*

Oil \_\_\_\_\_

Total Depth 3215

*2000 acid*

PRODUCTION

*Pump 1047 P & X*

1st 24 hrs. Nat. \_\_\_\_\_

1st 24 hrs. after shot \_\_\_\_\_

Gas \_\_\_\_\_ Cu. Ft.

Dry Hole \_\_\_\_\_

Abandoned \_\_\_\_\_

Date

JUN 21 1939<sub>19</sub>

S. J. LEWIS Scout