


Map No. KANSAS Sec. 33 Twp. 19 R. 9^w

Well No. 1 - Purcell Farm
Dietrick & Langston Company
NORTH

330 Ft. from N. Line
 Ft. from S. Line
 Ft. from E. Line
330 Ft. from W. Line
1931

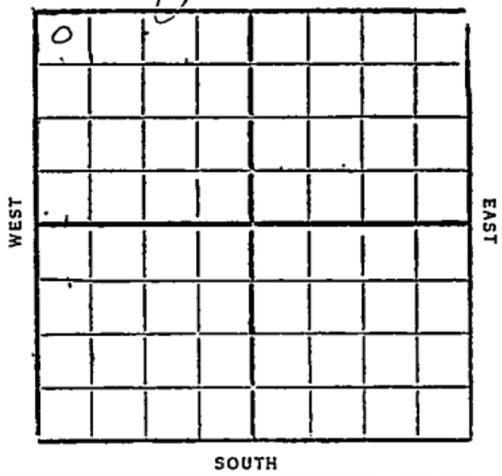

Date	REPORT
1/14	Loc
1/21	—
1/28	—
2/4	—
2/11	—
2/18	Reg
2/25	—
3/4	—
3/11	—
3/18	—
3/25	—
4/1	—
4/8	Stopdg
4/15	15' 1/2" - 130'
4/22	drlg 690'
4/29	516 1100' for csg.
5/6	UIC 12" - 1265"
5/13	516 12" - 1265"
5/20	drlg 1270'
5/27	10" - 1547
	(over)

6/3- 10"-1552
drlg up U/R logs 1574

6/10- drlg 1695'

6/17- " 2080'

6/24- HFW 2190-2200
U/R 8" esg

7/1- 8"-2270
drlg 2330'

7/8- 4 bailers water
2465-75 Drlg. 2768'

7/15- small sho oil 2939-48
" " and 1 1/2
bailer water hr 3002-08
6"-2784
drlg 3140'


7/21- Top Conglomerate 3218
150' oil. 3244-56
1600' oil 3274-76
T.D. 3297' Cong.
2400' oil in hole
being 5 day accumulation
Well swab
set 5"-3230
(Well reported very light
and running low)

7/22- Had 2400' oil at 3297
swabbed down
filled 175 ft fluid / hr
4 hr after swabbing
made 8 bailers water
deepened to T.D. 3300
filled with 400 ft. fluid
Mostly water - appears HFW

Map No. 1-15 Sec. 33 Twp. 19 R. 9W

Well No. 1-Curell Farm
Detrick & Langston Company

330 Ft. from N. Line
 Ft. from S. Line
 Ft. from E. Line
330 Ft. from W. Line

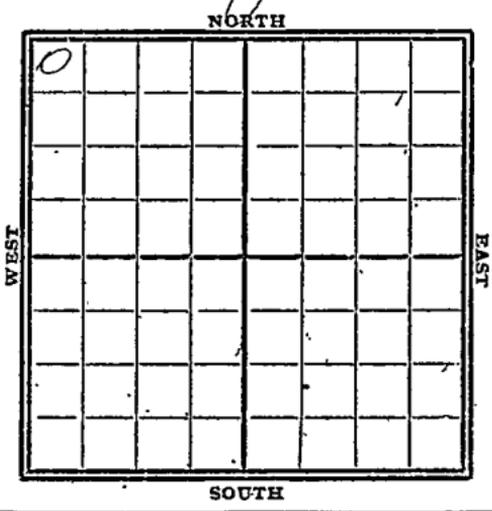

1931

Date	REPORT
7/29	Drg 3320'
8/5	" 3375 lene
8/12	T.D. 3375
	Will PB to 3285' and shoot
8/19	—
8/26	T.D. 3375
	PB to 3285
	shot 15 qt 3265-80
	400' oil & 100' water
	in 14 hours
	Will shoot again
	(PB 3285)
	shot 40 qt 3265-85
	Est 25 bbl oil &
	10 bbl water
	May abandon
	(over)

9/9. Top Cong. 3218

TD. 3375

shot 15 qt 3265-80

" 40 " 3265-85.

Made 36 bbl oil
and 36 " water
in 48 hours

Abandoned

Rice
 Map No. KANSAS Sec. 33 Twp. 19 R. 9 W
 Well No. 49 1 Purcell

Dee Tick & Langston Company
 Contractor

SECTION PLAT

330 Ft. from N. Line
Ft. from S. Line
Ft. from E. Line
330 Ft. from W. Line

0			

FIRST REPORTS

Location
 Rig up
 Drilling and Remarks:

RECORD

Cased in., ft.
 Sand
 Gas
 Oil
 Total Depth

PRODUCTION

1st 24 hrs. Nat.
 1st 24 hrs. after shot
 Gas Cu. Ft.
 Dry Hole
 Abandoned

Date

JAN 14 1931 1932 S. J. LEWIS Scout

Handwritten scribbles and lines, possibly representing a signature or a set of initials.

Returned	<i>JP</i>
Cards	
Trains	<i>OK</i>
France Map	<i>X</i>
Scarborough Map	<i>X</i>
Moody Map	<i>X</i>
Scarborough: 18.0k	
Moody: 18.0k	

49 *Rice*
 Map No. **KANSAS** Sec. *33* Twp. *19* R. *9* ^W

Well No. *1* *Purell*

Die Mink & Langston Company

Contractor

COMPLETED

SECTION PLAT

330 Ft. from N. Line

..... Ft. from S. Line

..... Ft. from E. Line

330 Ft. from W. Line

ABANDONED

0			

Location.....

Rig up.....

Drilling and Remarks:

Top Cong 3218

Shot 15/3765-80

" 40/3765-85

36 Als oil } 48 hrs
36 " water }

RECORD

Cased..... in., ft.

Sand.....

Gas.....

Oil.....

Total Depth *3375*

PRODUCTION

1st 24 hrs. Nat.....

1st 24 hrs. after shot.....

Gas..... Cu. Ft.

Dry Hole.....

Abandoned

Date

SEP 9 1931 *192* CHAS. L. SHERWOOD

Scout

Handwritten scribbles and lines, possibly representing a map or diagram.

Returned	<i>TP</i>
Cards	<i>TP</i>
Tracing	<i>CPK</i>
France Map	<i>X</i>
Scarborough Map	<i>X</i>
Moody Map	<i>X</i>
Scarborough Flat Book	
Moody Flat Book	