


McPherson

DX 78-1

KANSAS

Section 33 Township 19 Range 2W
Well No. #3 Koehn
Company National Assoc. Pet.

NORTH

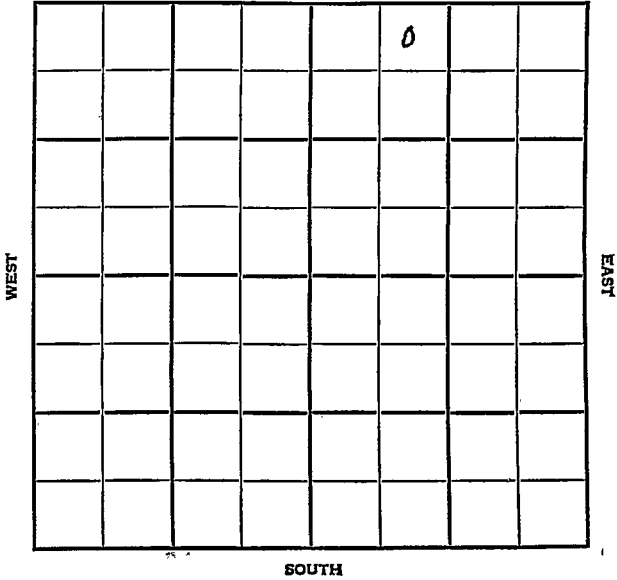

SOUTH

McPherson KANSAS

SEC.	TWP.	R.
33	19	2W ✓

WELL NO.

3 Koehn

FARM

COMPANY

National Assoc. Petr.

CONTRACTOR

Lincoln

Lively Pool


330 Ft. from N. Line

Ft. from S. Line

Ft. from E. Line

990 Ft. from W. Line

NE NW NE

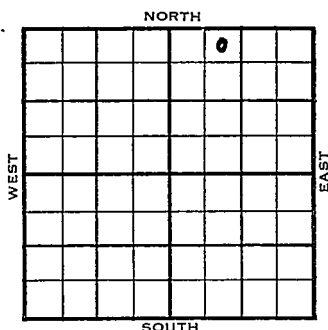

1954

ELEVATION

1547'

REPORT

5/5

Spud 4-30-54

8" @ 171'

Drlg. 2410'

5/12

Miss 2968'

RTD 2979'

5" @ 2975'

CO 2979'

2/3 BO + 3 BWPH 10 hrs.

6/9

Spud 4-30-54

Oil Well

TD 2979'

8" @ 171'

Miss 2968'

TD 2979'

5" @ 2975'

CO to 2979'

S/3 bo 3 bwph

Comp. 33 bopd 80% wtr.

COMPLETED

County McPherson State Kansas
 (Blk.) (Sur.)
 Sec. 33 19 Map No. 27
 (Twp.) (Rge.)
 Operator National Assoc. Pet.
 Well No. 3 Farm Keohn
 Elev. 1547 Location NE NW NE

350 Ft. From W Line NE
990 Ft. From W Line Quarter
 Ist. Report MAY 5 1954

Completion _____

Remarks _____

Lincoln - Contr.


Spudding Date 4-30-54

Drlg. Data _____

Lively Pool

8" @ 171 drlg. 2410

County McPherson State Kansas
 Sec. 33 (Blk. 19) (Sur. 2W) Map No. _____
 Operator National Assoc. Pet.
 Well No. 3 Farm Koehn
 Elev. 1547 Location NE NW NE

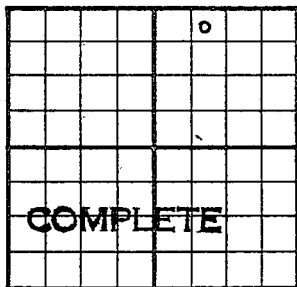

330 Ft. From N Line NE
990 Ft. From W Line Quarter
 Ist. Report _____
 Completion JUN 9 1954
 Remarks Lively Pool
Lincoln - Contr.
 Spudding Date 4-30-54

Drlg. Data Oil well TD 2979
8" @ 171 Miss. 2968 TD 2979
5" @ 2975 CO to 2979 S/ 3 bo 3 bwph
Comp. 33 bopd 80% wtr.

J. G. McGREE