


Section 33 Township 19 Range 2W
Well No. 1 Akeson
Company N C R A

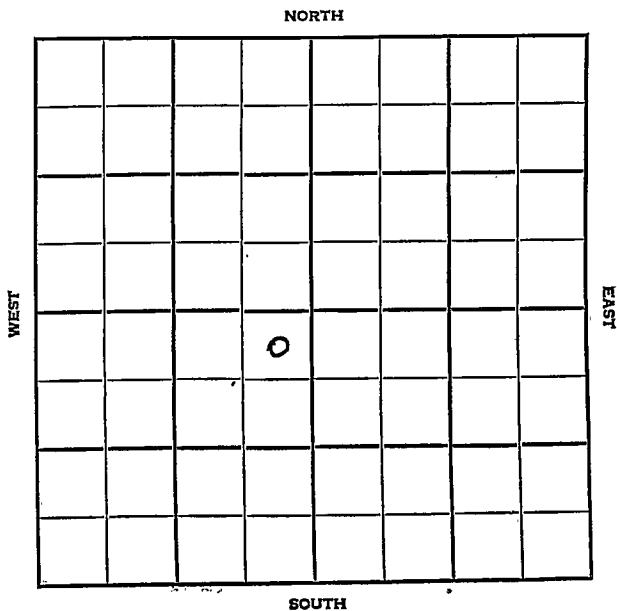

McPherson KANSAS

SEC.	TWP.	R.
33	19	2W

WELL NO. _____

COMPANY 1 Akeson FARM

CONTRACTOR N C R A

Musgrove


Lively Pool

330 _____ Ft. from N. Line

_____ Ft. from S. Line

330 _____ Ft. from E. Line

_____ Ft. from W. Line

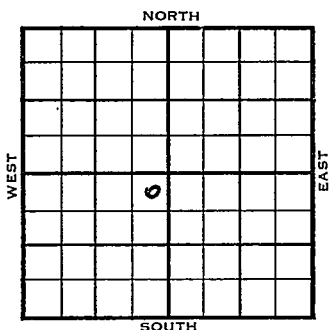

NE NE SW

	ELEVATION	REPORT
1954	1540'	

6/30	8" @ 159 Drlg. 650
7/7	Lans. 2328' Miss 2959 RTD 2963 5" @ 2961'
7/21	Spud 6-27-54 D & A TD 2975 8" @ 159 Lans 2328 Miss 2959 TD 2963 5" @ 2961 GO to 2963 FU 10 GO 115 GW 12 hr. B/4 $\frac{1}{2}$ GF 2 hr. 80% oil 1250 A FU 200' oil 1000' wtr. 12 hr. DD 2975 1 BO 29 BW 9 hr. D & A

ABANDONED

KansasCounty **McPherson** StateSec. **33** (Blk.) **19** (Sur.) **2W** Map No.Operator **N C R A**Well No. **1** Farm **Akeson**Elev. Location **NE NE SW**


330 Ft. From **N** Line **SW****330** Ft. From **E** Line **Quarter**1st. Report **JUN 30 1954**

Completion

Remarks

Musgrove - Contr.Spudding Date **6-27-54**Drlg. Data **Lively Pool****8" @ 150 drlg. 650****J. G. McGEHEE**

County McPherson State Kansas
 Sec. 33 (Blk.) 19 (Sur.) 2W Map No.
 Operator N C R A
 Well No. 1 Farm Akeson
 Elev. 1540 Location NE NE SW

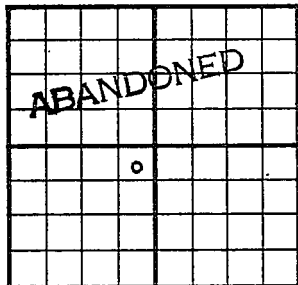

330 Ft. From N Line SW
330 Ft. From E Line Quarter
 Ist. Report
 Completion JUL 21 1954
 Remarks Lively Pool
Musgrove - Contr.
 Spudding Date 6-27-54

Drilg. Data D & A TD 2975
8" @ 159 Lans. 2328 Miss. 2959
TD 2963 5" @ 2961 CO to 2963
FU 10 go 115 gw 12 hr. B/ 4 $\frac{1}{2}$ gf 2 hr.
80% oil 1250A FU 200' oil 1000' wtr.
12 hr. DD 2975 1 bo 29 bw 9 hr.

D & A

J. G. McGEHEE