


Section 33 Township 19 Range 2W

Well No. 1 Hull

Company Geo. Hess

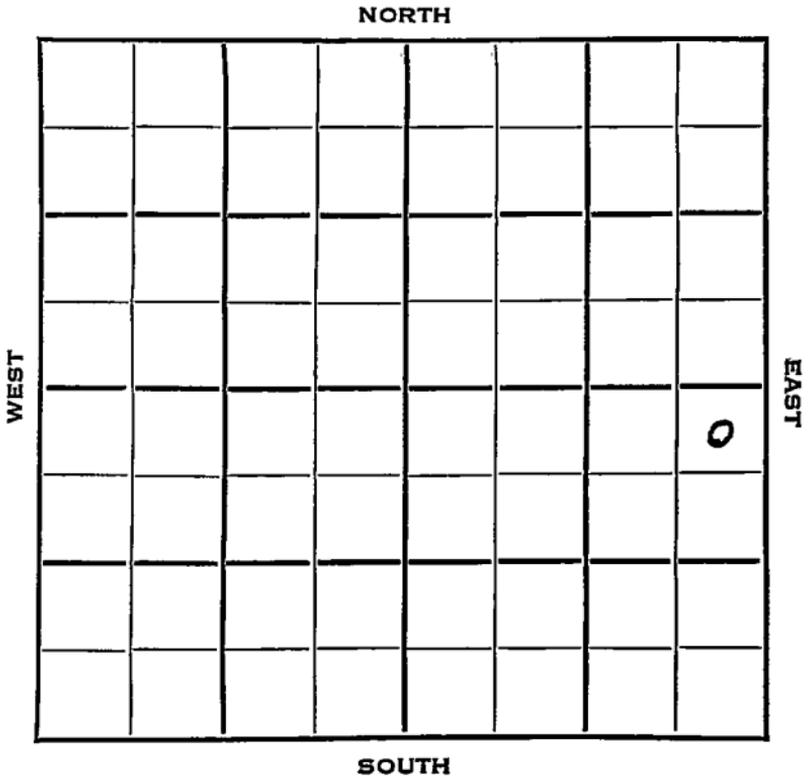

McPherson KANSAS


SEC.	TWP.	R.
33	19	2W ✓

WELL NO. 1 Hull FARM

COMPANY Geo. Hess

CONTRACTOR Mallard Drlg. Lively Pool

330 Ft. from N. Line
 _____ Ft. from S. Line
 330 Ft. from E. Line
 _____ Ft. from W. Line

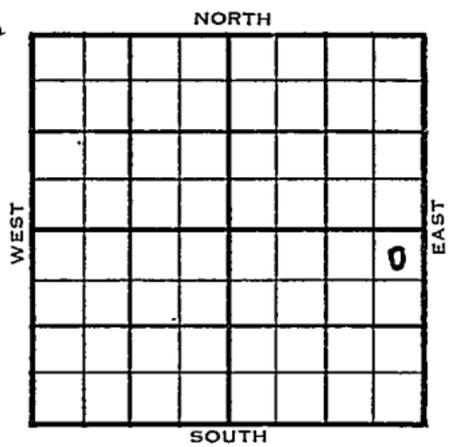

NE NE SE

1954	ELEVATION	REPORT
	15 46'	

1/13 Location
 1/20 "
 1/27 8" @ 157' w/100 sks
 Drlg. 900'
 2/3 KC 2330, Miss 2959
 TD 2963
 5" @ 2961½
 DD 2964½
 B/1 goph 4 hrs.
 2/10 500 A Flowed 8 BOPH 10 hrs + 1 M Gas
 2/17 POP
 2/24 "
 3/3 POP
 3/10 NR
 3/17 NR
 3/24 "
 3/31 Spud 1-22-54
 Oil Well
 TD 2964'
 8" @ 157'
 KC 2330', Miss 2959',

OVER

1954

Information brought forward.

3/31

TD 2963'

5" @ 2961'

DD 2964'

B/ 1 boph 4 hr.

500 A F/ 8 boph 10 hr.

F/ 20 boph

Comp 690 bopd.

COMPLETED

County 33 McPherson State Kansas

Sec. 25 (Blk. (Twp.) 19) (Sur. (Rge.) 2W) Map No.

Operator Geo. Hess

Well No. 1 Farm Hull

Elev. Location NE NE SE

330 Ft. From N Line SE

330 Ft. From E Line Quarter

1st. Report JAN 13 1954

Completion

Remarks

Mallard Drig. - Contr.

Spudding Date

Drig. Data Lively Pool

Location

JAN 14 1954

Scout Cards	12
Land Small Map	
Land Wall Map	3
Tracings	
France Map	
Pierce Map	
Misc.	

Orig. Data

County McPherson State Kansas

Sec. 33 (Blk. 19) (Sur. Rge. 2W) Map No. _____

Operator Geo. Hess

Well No. 1 Farm Hull

Elev. 1546 Location NE NE SE

330 Ft. From N Line SE

330 Ft. From E Line Quarter

Ist. Report _____

Completion MAP 21 1054

Remarks Lively Pool

Mallard Drlg. - Contr.

Spudding Date 1-22-54

Drlg. Data Oil well TD 2964

8" @ 157 KC 2330 Miss. 2959

TD 2963 5" @ 2961 DD 2964 B/ 1 boph

4 hr. 500 A F/ 8 boph 10 hr.

F/ 20 boph Comp. 690 boph

J. G. McGEHEE

APR 6

1954

Scout Cards
Land Small Map
Land Wall Map
Tracings
France Map
Pierce Map
Misc

Orig. Date