

Section 33 Township 19 Range 1WWell No. 1 GriffithCompany Don Ingling

NORTH


13

0							

SOUTH

WEST

EAST

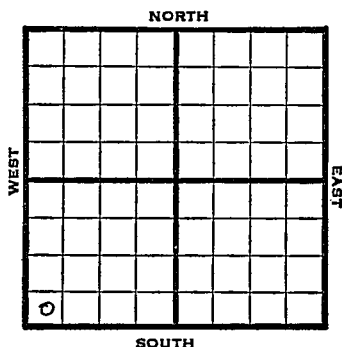Sec. 33 Twp. 19 R. 1WWell No. #1 Griffith FarmDon Ingling CompanyRitz-Canton Ft. from N. Line330 Ft. from S. Line Ft. from E. Line330 Ft. from W. Line

SW/C

1948

Elev. 1580' REPORT

4/28

8" @ 138'

WOC

5/5

Drlg. 2212'

5/12

Mississippi 2949'

TD 2971'

5" @ 2955'

RUST

5/19

3500 Acid 1/2 M Gas

5/26

Miss 2949'

5 1/2" @ 2955'

3500 Acid

Gas 750,000

R. Pr. 700#

TD 3011'

COMPLETED

Map No. _____ Sec. 33 Twp. 19 R. 1W

Well No. 1 Griffith

Don Ingling Company

FIRST REPORT Contractor

SW/C


SECTION PLAT

_____ Ft. from N. Line

330 Ft. from S. Line

_____ Ft. from E. Line

330 Ft. from W. Line

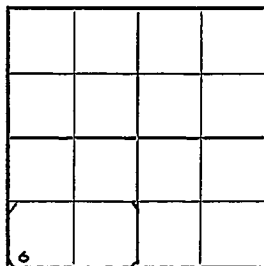

McPherson County

Location _____

Rig up _____

Drilling and Remarks:

8" @ 138 WOC

RECORD

Cased _____ in., _____ ft.

Sand _____

Gas _____

Oil _____

Total Depth _____

PRODUCTION

1st 24 hrs. Nat. _____

1st 24 hrs. after shot _____

Gas _____ Cu. Ft.

Dry Hole _____

Abandoned _____

Date

APR 28 1948 19 _____ S. J. LEWIS Scout

Map No. 43 Sec. 33 Twp. 19 R. 1WWell No. 1 GriffithDon Ingling Company

COMPLETE

Contractor

SW/C

E. 1580
SECTION PLAT Ft. from N. Line330 Ft. from S. Line Ft. from E. Line330 Ft. from W. Line

5			

McPherson County

RECORD

Location Rig up

Drilling and Remarks:

Miss 2949
5 1/2" @ 2955
3500 Acust
750,000 Gas
700# R/L

Cased in., ft.Sand Gas Oil Total Depth 2911

PRODUCTION

1st 24 hrs. Nat. 1st 24 hrs. after shot Gas Cu. Ft.Dry Hole Abandoned

Date

MAY 26 1948 19 S. J. LEWIS Scout