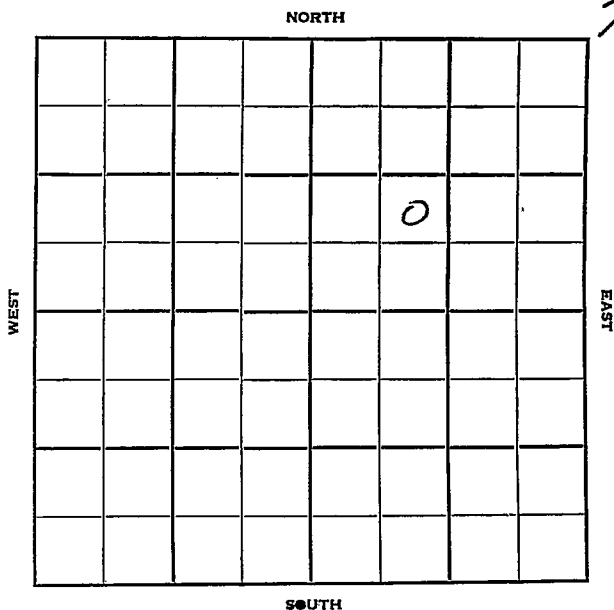


Section 33 Township 19 Range 12WWell No. #1 WirtzCompany W. L. Hartman

Barton

KANSAS

Sec. 33 Twp. 19 R. 12W

Well No. #5 Wirtz Farm

W. L. Hartman Company

W. L. Hartman -Contr. Contractor

 Ft. from N. Line

990'


 Ft. from S. Line

 Ft. from E. Line

990'

 Ft. from W. Line

NE SW NE

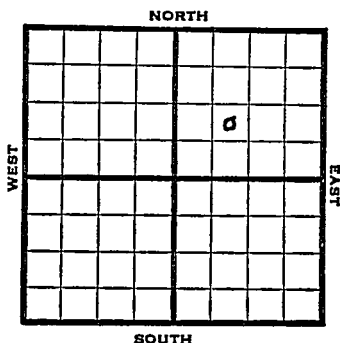

1952

Elev. 1811

R E P O R T

7/2

Spud 6-25-52

8" @ 129

Drlg. 2870'

7/9

Topeka 2709' Heeb 2923' Br li 3093'

Lans. 3109'

Drlg. 3363'

7/17

Cong. 3358' Arb. 3394' RTD 3395'

5" @ 3394'

7/23

CO DD 3397 TD 1000' oil 12 hr.

S/ 32 Bo 6 hrs.

7/30

500 A fill up 3000' oil 12 hrs.

S/ 5 Boph POP

8/6

NR

8/13

"

8/20

"

8/27

"

9/3

NR

9/10

Spud 6-25-52 Oil Well TD 3397

8" @ 129 Top 2709 Heeb. 2973

Br lime 3093 Lans. 3109

Cong 3358 Arb. 3394

TD 3395 5" @ 3394

DD 3397 FU 1000' oil 12 hr.

S/32 bo 6 hr. 500 A FU 3000' oil

12 hr. S/5 boph Comp. 114 bopd

COMPLETED

County Barton State KansasSec. 33 (Blk.) 19 (Sur.) 12W Map No.Operator W. L. HartmanWell No. 5 Farm WirtzElev. Location NE SW NE

FIRST REPORT

990 Ft. From S Line NE990 Ft. From W Line Quarter1st. Report JUL 2 1952

Completion

Remarks

W. L. Hartman - Contr.Spudding Date 6-25-52

Drlg. Data

8" @ 129 Drlg. 2870

J. G. McGEHEE

J. G. McGEHEE