

Section 33 Township 19 Range 2W

Well No. #10 Johnson A-B

Company G M R Oil

NORTH

4

	0						

SOUTH

WEST

EAST

Sec. 33 Twp. 19 R. 12WWell No. #10 Johnson A-B Farm

G M R Oil

Company

it

Contractor

990

Ft. from N. Line


Ft. from S-Line

Ft. from E. Line

990

Ft. from W. Line

SE NW NW

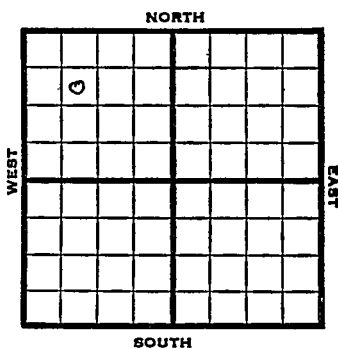

1952

Elev. 1817' REPORT

11/12

Spud 11-9-52
8" @ 160'

11/20

Heeb 2982' Br li 3102' Lans. 3120'
 DST 3289-3301, 1 hr, 110' SW 750#
 Arb. 3400
 DST 3401-21 1 hr, 663' sulp wtr.
 1080#
 Drlg. 3458' for SWD

11/27

NR

12/4

RTD 3606
 5" @ 3450

12/11

15/3402-07 SO 250A S/300 Ft Water
 30 Miss

12/18

NR

12/25

NR

1/1

NR

1/8

CO 3606

1/23

Spud 11-9-52
 SWD Well
 TD 3606
 8" @ 160

Heeb 2982, Br lime 3102, Lans
 3120

OVER

#10 Johnson A-B

1958 Information Brought Forward)

1/23 DST 3289-3301, opn 1 hr., rec.

110' sw, 750#

Arb. 3400

DST 3401-21, opn 1 hr., rec.

663' sul wtr., 1080#

TD 3606

5" @ 3450

15/3402-07, 250A

S/300' wtr 30 mins.

Comp. for SWD Well

ABANDONED

J. G. McGEHEE

County Barton State KansasSec. 33 (Blk.) 19 (Sur.) 12W Map No.Operator G-M-R OilWell No. 10 Farm Johnson A-BElev. 1817 Location SE NW NW

	o						

990 Ft. From N Line NW990 Ft. From W Line Quarter

1st. Report

Completion JAN 23 1953

Remarks

G-M-R - Contr.Spudding Date 11-9-52Drig. Data SWD well TD 36068" @ 160 Heeb. 2982 Br. lime 3102Lans. 3120 DST 3289-3301 open 1 hr.Rec. 110' sw 750# Arb. 3400DST 3401-21 open 1 hr. Rec. 663' sulwtr. 1080# TD 3606 5" @ 345015/ 3402-07 250 A S/ 300' wtr. 30 min.Comp. for SWD well

J. G. McGEHEE