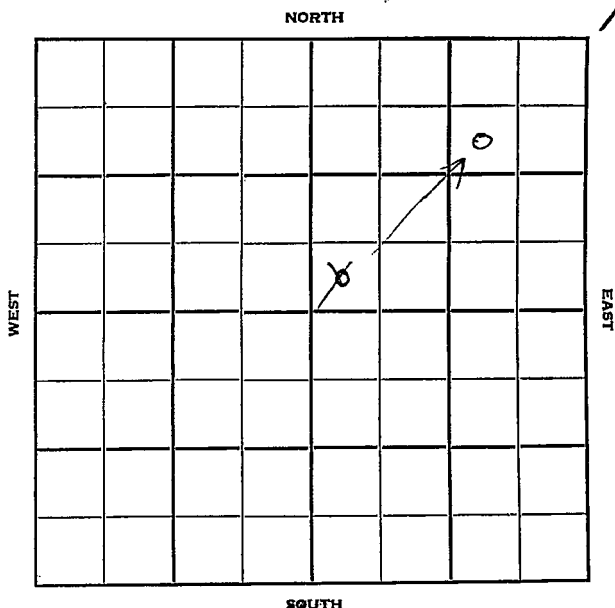
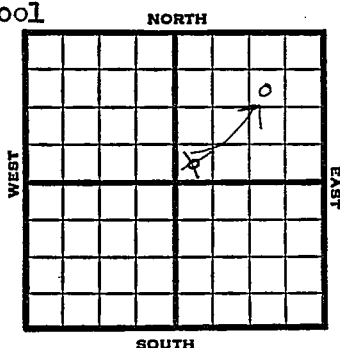


Section 33 Township 19 Range 12WWell No. 2 WirtzCompany W. L. Hartman

Sec. 33 Twp. 19 R. 12W ✓Well No. #2 Wirtz FarmW. L. Hartman Company

Contractor

Fort Zarah Pool

990' Ft. from N. Line330' Ft. from S. Line990' Ft. from E. Line330' Ft. from W. LineNE
SW ~~SW~~ NE

1951

Elev. 1811 REPORT

8/1

Location

9/12

Spud 7-31-51

Oil Well TD 3377

8" @ 108' Anhy 617

Top. 2708 Heeb. 2970

B. Oread 3007 Br Lime 3087

KC 3103

DST 2909-31 opn 1 hr Rec. 30' mud
&SSODST 3103-17 opn $\frac{1}{2}$ hr Rec. 55' mud

DST 3123-40 opn 1 hr Rec. 10' mud

DST 3140-57 opn 1 hr Rec. 20' mud

DST 3165-82 opn 1 hr Rec. 45' gem

SSO 500' gas

DST 3187-3203 opn 1 hr Rec. 25' mud

DST 3231-44 opn $\frac{1}{2}$ hr Rec. 5' mudDST 3256-66 opn $\frac{1}{2}$ hr Rec 5' mudDST 3266-64 opn $\frac{1}{2}$ hr Rec 8' mudDST 3294-3310 opn $\frac{1}{2}$ hr

Rec. 4' mud

DST 3223-35 opn 1 hr Rec. 510' gas

DST 3338-48 opn $\frac{1}{2}$ hr Rec 6' mud

Arb. 3357-58 5" @ 3358


TD 3377 S/36 bo 12 hr.

Comp. 586 bopd

COMPLETED

J. E. TYRA

County Barton State Kansas
 Sec. 33 (Blk.) 19 (Sur. Rge.) 12W Map No. _____
 Operator W. L. Hartman
 Well No. 2 Farm Wirtz
 Elev. 1811 Location SW NE NE

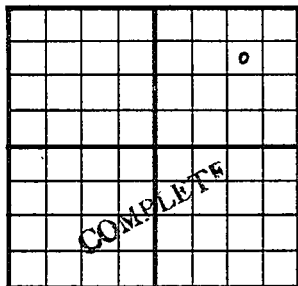

990 Ft. From N Line NE
990 Ft. From E Line Quarter
 Ist. Report _____
 Completion SEP 12 1951
 Remarks Fort Zarah Pool
 Spudding Date 7-31-51

Drlg. Data Oil well TD 3377
8" @ 108 Anhy 617 Top. 2708 Heeb. 2970
B. Oread 3007 Br. lime 3087 KC 3103
DST 2909-31 open 1 hr. Rec. 30' mud & SSO
DST 3103-17 open 1/2 hr. Rec. 55' mud
DST 3123-40 open 1 hr. Rec. 10' mud
DST 3140-57 open 1 hr. Rec. 20' mud
DST 3165-82 open 1 hr. Rec. 45' gcm SSO
500' gas DST 3187-3203 open 1 hr.
Rec. 25' mud DST 3231-44 open 1/2 hr.
Rec. 5' mud DST 3256-66 open 1/2 hr.
Rec. 5' mud DST 3266-84 open 1/2 hr.
Rec. 8' mud DST 3294-3310 open 1/2 hr.
Rec. 4' mud DST 3223-35 open 1 hr.
Rec. 510' gas DST 3338-48 open 1/2 hr.

J. E. TYRA

Map No. _____ Sec. 33 Twp. 19 R. 12WWell No. 2 Wirtz_____
W. L. Hartman Company**CORRECTION** Contractor

SW NE NE

SECTION PLAT

990 Ft. from N. Line_____
Ft. from S. Line990 Ft. from E. Line_____
Ft. from W. Line

			o

Barton County

Location _____

Rig up _____

Drilling and Remarks:

Reported

SW SW NE

RECORD

Cased _____ in., _____ ft.

Sand _____

Gas _____

Oil _____

Total Depth _____

PRODUCTION

1st 24 hrs. Nat. _____

1st 24 hrs. after shot _____

Gas _____ Cu. Ft.

Dry Hole _____

Abandoned _____

Date

AUG 1 1951 19J. E. TYRA

Scout

Drig. Data

Rec. 6' mud Arb. 3357-58 5" @ 3358

TD 3377 S/ 36 bo 12 hr.

Comp. 586 bopd

SEP 19 1951

Scout Cards
Land Small Map
Land Wall Map
Tracings
France Map
Pierce Map
Misc.