FORM 51 25M 8-50 WESTERN


Barton

KANSAS

Section 33 Township 19 Range 12W

Well No. #1 Johnson (A)

Company G-M-R Oil

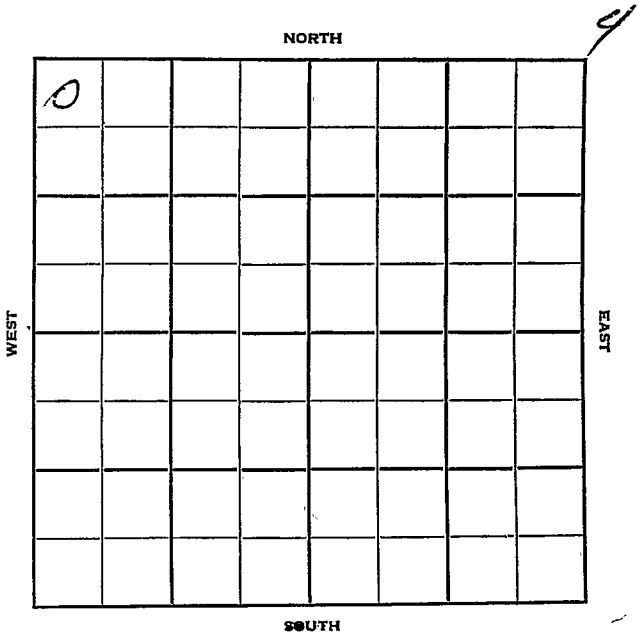

FORM 252-B
10M 11-50 PETROL

Barton KANSAS

Sec. 33 Twp. 19 R. 12W

Well No. #1 Johnson (A) Farm

G-M-R Oil Company

Contractor


330' Ft. from N. Line

Ft. from S. Line

Ft. from E. Line

330' Ft. from W. Line

NW NW NW

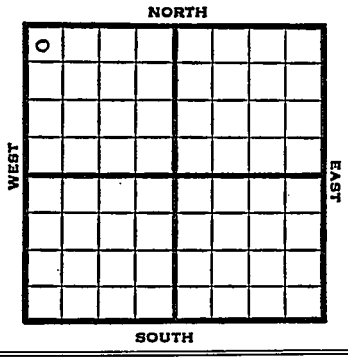

1951	Elev. 1816' REPORT
6/13	8" @ 150 Drlg. 1694'
8/8	Spud 6-10-51 Oil Well TD 3393 8" @ 150 Heeb. 2983 Br Lime 3104 Lans. 3119 Cong. 3367 Arb. 3378-89 5" @ 3386 TD 3393 1000 A S/4 boph S/2¼ boph 4/3379-80 1500 A S/10 boph Comp. 355 bopd **COMPLETED**

FORM 275 FOR SALE BY KANSAS BLUE PRINT CO.


County Barton State Kansas

Sec. 33 (Blk. Twp.) 19 (Sur. Rge.) 12W Map No.

Operator G-M-R Oil

Well No. 1 Farm Johnson (A)

Elev. Location NW NW NW

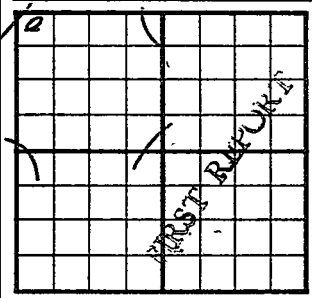

330 Ft. From N Line NW

330 Ft. From W Line Quarter

1st. Report JUN 13 1951

Completion

Remarks

Spudding Date 6-10-51

Drlg. Data

8" @ 150 Drlg. 1694

J. E. TYRA

FORM 275 FOR SALE BY KANSAS BLUE PRINT CO.


County Barton State Kansas

Sec. 33 (Blk. Twp.) 19 (Sur. Rge.) 12W Map No.

Operator G-M-R Oil

Well No. 1 Farm Johnson "A"

Elev. 1816 Location NW NW NW

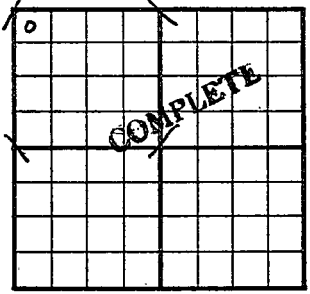

330 Ft. From N Line NW

330 Ft. From W Line Quarter

1st. Report

Completion AUG 8 1951

Remarks Fort Zarah Pool

Spudding Date 6-10-51

Drlg. Data Oil well TD 3393

8" @ 150 Heeb. 2983 Br. lime 3104

Lans. 3119 Cong. 3367 Arb. 3378-89

5" @ 3386 TD 3393 1000 A S/4 boph

S/ 2½ boph 4/ 3379-80 1500 A

S/ 10 boph Comp. 355 bopd

J. E. TYRA