
FORM 51 25M 8-50 WESTERN Barton KANSAS

Section 33 Township 19 Range 12W

Well No. #2 Button

Company Graham-Messman-Rinehart oil Co.

12

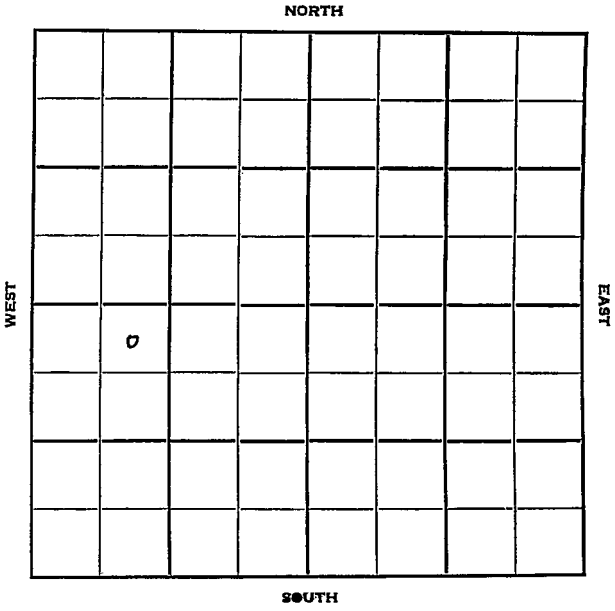

FORM 252-B
10M 8-51 TPCO.

Barton KANSAS

Sec. 33 Twp. 19 R. 12W

Well No. #2 Buttan Farm

Graham-Messman-Rinehart Oil Co. Company

G-M-R Oil - Contr. Contractor

Darthmouth Pool


330' Ft. from N. Line

Ft. from S. Line

Ft. from E. Line

990' Ft. from W. Line

NE NW SW

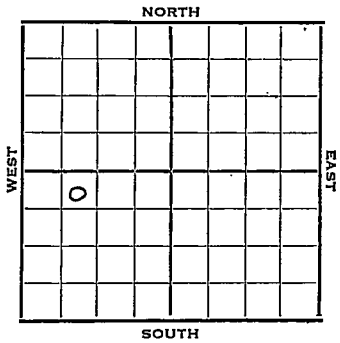

1951	Elev.1814' REPORT
11/28	Spud 11-23-51 8" @ 165 Anhy 627 Drlg. 2188'
1952 1/9	Spud 11-23-51 Oil Well TD 3400 8" @ 165 Anhy 627 Heeb. 2986 Br Lime 3106 Lans. 3123 Arb. 3365 TD 3400 5" @ 3400 CO to 3396 20/3383-88 500 A S/4 boph Comp. 149 bopd COMPLETED

FORM 275 FOR SALE BY KANSAS BLUE PRINT CO.

County Barton State Kansas

Sec. 33 (Blk. Twp.) 19 (Sur. Rge.) 12W Map No.

Operator Graham-Messman-Rinehart Oil Co.

Well No. 2 Farm Button

Elev. Location NE NW SW



330 Ft. From N Line SW

990 Ft. From W Line Quarter

1st. Report NOV 28 1951

Completion

Remarks

G-M-R Oil - Contr.

Spudding Date 11-23-51

Drlg. Data Darthmouth - pool

8" @ 165 Anhy 627 Drlg. 2188

J. E. TYRA

FORM 275 FOR SALE BY KANSAS BLUE PRINT CO.


County Barton State Kansas

Sec. 33 (Blk. / Twp.) 19 (Sur. / Rge.) 12W Map No.

Operator G-M-R Oil

Well No. 2 Farm Button

Elev. 1814 Location NE NW SW

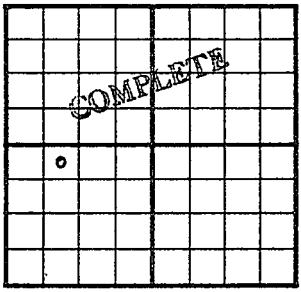

330 Ft. From N Line SW

990 Ft. From W Line Quarter

1st. Report

Completion JAN 9 1952

Remarks Dartmouth Pool

G-M-R - Contr.

Spudding Date 11-28-51

Drlg. Data Oil well TD 3400

8" @ 165 Anhy 627 Heeb. 2986

Br. lime 3106 Lans. 3123 Arb. 3365

TD 3400 5" @ 3400 CO to 3396

20/ 3383-88 500 A S/ 4 boph

Comp. 149 bopd

J. E. TYRA