FORM 51 25M 8-50 WESTERN

Barton KANSAS

Section 33 Township 19 Range 12 W

Well No. # 2 Riverbed "A"

Company Derby Oil

S

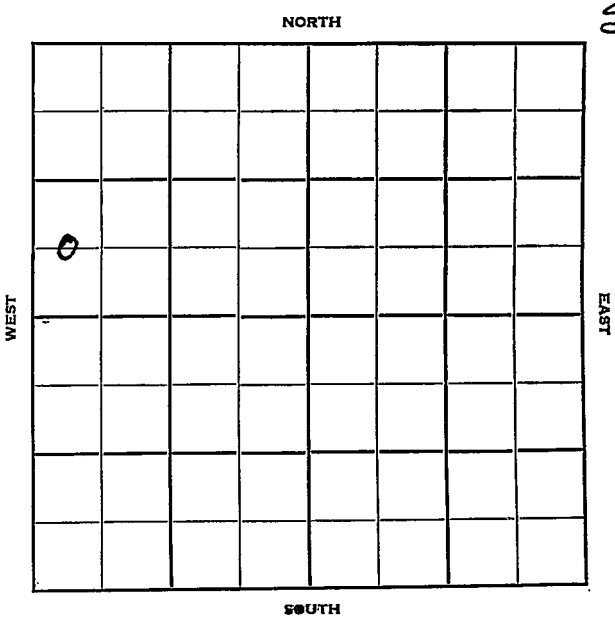

FORM 252-B
10M 8-51 TPCO.

Barton KANSAS

Sec. 33 Twp. 19 R. 12W

Well No. #2 Riverbed "A" Farm

Derby Oil Company

Contractor

Ft. from N. Line

660' Ft. from S. Line

Ft. from E. Line

330' Ft. from W. Line

C W L SW NW

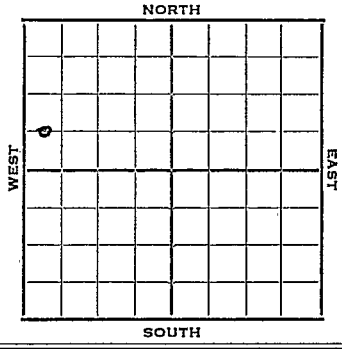

1952	Elev. 1816' REPORT
3/19	Location
3/25	8" @ 134' Drlg. 2030'
4/1	Heeb 2982' Br. li 3104' Lans. 3119' DST 3125-90, 1/2 hr, 4' M O# Arb. 3366-70' RTD 5" @ 3367' WOC
4/9	CO to 3370 S/1½ BO 1st hr. S/2 BO 3rd hr. 500 A S/25 BO 13 hrs. DD to 3378 S/2½ BOPH 1000 A DD to 3384 TD S/10 BOPH for 10 yrs. 500A S/15 BO 1st hr. S/17½ BO 2nd hr.
4/23	POP
4/30	P/ 235 BO & 20 bopd
5/7	NR
5/14	"
5/20	"
5/28	Spud 3-21-52 Oil Well TD 3384 8" @ 134' Heeb. 2982 Br Li 3104 Lans. 3119' DST 3125-90 open ½ hr.rec. 4' mud Arb. 3366-70 5" @ 3367 TD 3370 S/ 1½ bo 1 hr. S/ 2 BO 3rd hr. 500 A S/ 25 bo 13 hr. DD 3378 S/ 2½ boph 1000 A DD 3384 S/ 10 boph 500 A S/ 15 boph 17½ boph Comp. 178 bopd 28% wtr. **COMPLETED**

FORM 275 FOR SALE BY KANSAS BLUE PRINT CO.

County Barton State Kansas

Sec. 33 (Blk. Twp.) 19 (Sur. Rge.) 12W Map No.

Operator Derby Oil

Well No. 2 Farm Riverbed "A"

Elev. Location C W L SW NW

660 Ft. From S Line NW

330 Ft. From W Line Quarte

1st. Report MAR 1 9 1952

Completion

Remarks

Spudding Date

FIRST REPORT

Drlg. Data

Location

J. G. McGEHEE

FORM 275 FOR SALE BY KANSAS BLUE PRINT CO.

County Barton State Kansas

Sec. 33 (Blk. Twp.) 19 (Sur. Rge.) 12W Map No.

Operator Derby Oil

Well No. 2 Farm Riverbed "A"

Elev. 1816 Location C W L SW NW

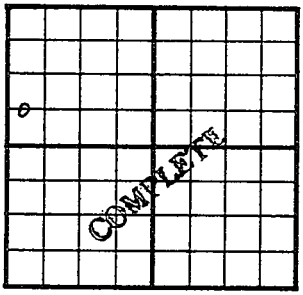

660 Ft. From S Line NW

330 Ft. From W Line Quarter

1st. Report

Completion MAY 28 1952

Remarks

Spudding Date 3-21-52

Drlg. Data Oil well TD 3384

8" @ 134 Heeb. 2982 Br. lime 3104

Lans. 3119 DST 3125-90 open ½ hr.

Rec. 4' mud Arb. 3366-70 5" @ 3367

TD 3370 S/ 1½ bo 1 hr. S/ 2 bo 3rd hr.

500 A S/ 25 bo 13 hr. DD 3378

S/ 2½ boph 1000 A DD 3384 S/ 10 boph

500 A S/ 15 boph 17½ boph

Comp. 178 bopd 28% water

J. G. McGEHEE