FORM 51 25M 3-49 PETROL


Barton KANSAS

Section 33 Township 19 Range 12W

Well No. #2 Steckel "C"

Company W. J. Coppinger

12J

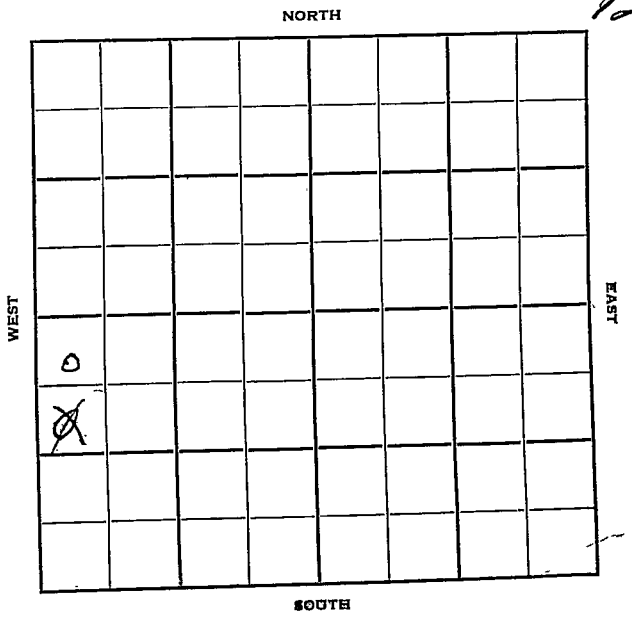

FORM 252-B
10M 10-50 PETROL

Barton KANSAS

Sec. 33 Twp. 19 R. 12W

Well No. #2 Steckel "C" Farm

W. J. Coppinger Company

G-M-R Contractor

Dartmouth Pool


~~500~~ ~~990'~~ Ft. from N. Line

Ft. from S. Line

Ft. from E. Line

330' Ft. from W. Line

~~SW NW SW~~
CW¼ NW SW

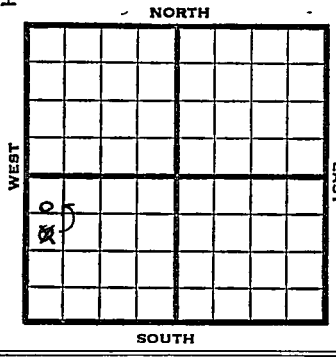

1951	Elev. 1816' REPORT
10/17	8" @ 156, Anhy 624 Heeb. 2989 Br Lime 3107 Lans. 3121 Drlg. 3123'
2/5	TD 3393 5" @ 3372 POP
2/13	POP
2/20	Spud 10-17-51 Oil well TD 3393' 8" @ 156 Anhy 624' Heeb 2989' Br. lime 3107' Lans. 3121' Arb. 3370' TD 3375' 5" @ 3372' CO to 3375' 2500 A S/3 BOPH 6 hr. DD 3393' 2500 A S/2 BOPH Comp. 157 BOPD COMPLETED

FORM 275 FOR SALE BY KANSAS BLUE PRINT CO.


County Barton State Kansas

Sec. 33 (Blk. Twp.) 19 (Sur. Rge.) 12W Map No.

Operator W. J. Coppinger

Well No. 2 Farm Steckel "C"

Elev. Location SW NW SW

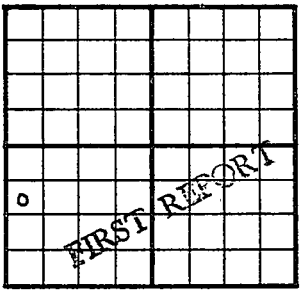

990 Ft. From N Line SW

330 Ft. From W Line Quarter

1st. Report OCT 24 1951

Completion

Remarks

G-M-R - Contr.

Spudding Date 10-17-51

Drlg. Data Dartmouth Pool

8" @ 156 Anhy 624 Heeb. 2989

Br. lime 3107 Lans. 3121 drlg. 3123

J. E. TYRA

FORM 275 FOR SALE BY KANSAS BLUE PRINT CO.


County Barton State Kansas

Sec. 33 (Blk. Twp.) 19 (Sur. Rge.) 12W Map No.

Operator W. J. Coppinger

Well No. 2 Farm Steckel "C"

Elev. 1816 Location C W LNW SW

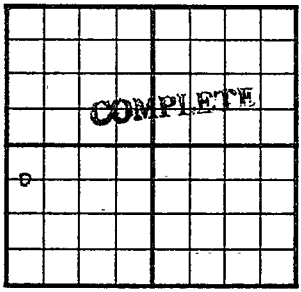

500 Ft. From N Line SW

330 Ft. From W Line Quarter

1st. Report

Completion FEB 2 0 1952

Remarks Dartmouth Pool

G-M-R - Contr.

Spudding Date 10-17-51

Drlg. Data Oil well TD 3393

8" @ 156 Anhy 624 Heeb. 2989

Br. lime 3107 Lans. 3121 Arb. 3370

TD 3375 5" @ 3372 CO to 3375

2500 A S/ 3 boph 6 hr. DD 3393

2500 A S/ 2 boph Comp. 157 bopd

J. G. McGEHEE

Form 26 200 Bks. 8-50 Petrol

Kansas

Map No. _____ Sec. 33 Twp. 19 R. 12W


Well No. 2 Steckel "C"

W. J. Coppinger Company

CORRECTION Contractor

C W L NW SW

SECTION PLAT

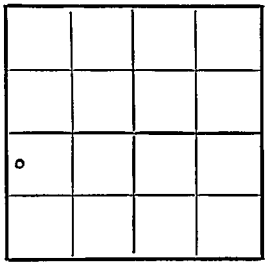

500 Ft. from N. Line

_____ Ft. from S. Line

_____ Ft. from E. Line

330 Ft. from W. Line

Barton County

Location _____

Rig up _____

Drilling and Remarks:

Reported

SW NW SW

RECORD

Cased _____ in., _____ ft.

Sand _____

Gas _____

Oil _____

Total Depth _____

PRODUCTION

1st 24 hrs. Nat. _____

1st 24 hrs. after shot _____

Gas _____ Cu. Ft.

Dry Hole _____

Abandoned _____

Date

OCT 31 1951 19 J. E. TYRA Scout