KANSAS

FORM 51

Rush

Section 33 Township 19 Range 16 W

Well No. # 2 Nagle

Company Alkay Oil of Tulsa

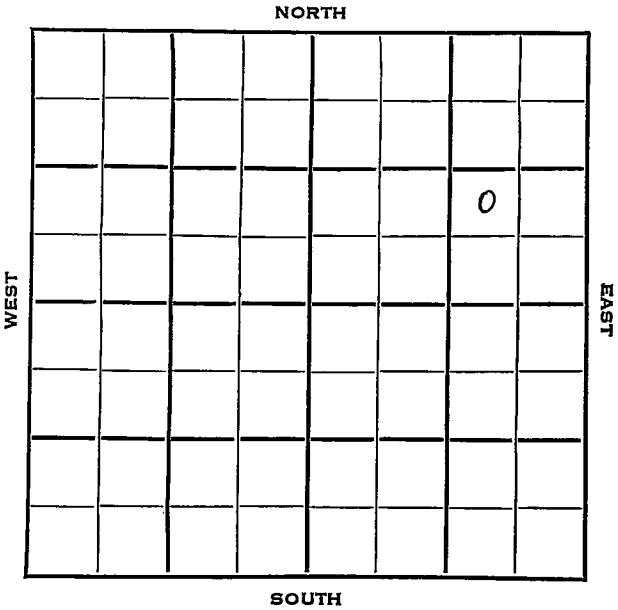

Rush KANSAS

| SEC. | TWP. | R. |
|---|---|---|
| 33 | 19 | 16W |

WELL NO. #2 Nagle FARM

COMPANY Alkay Oil of Tulsa

CONTRACTOR Duke & Wood

Ryan Pool

_____ Ft. from N. Line

990 Ft. from S. Line

990 Ft. from E. Line

_____ Ft. from W. Line

NW SE NE

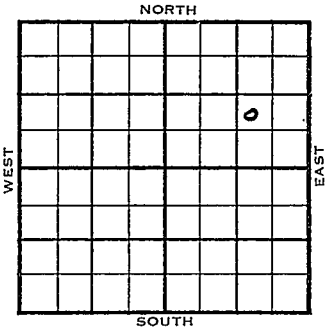


| 1954 | ELEVATION 2030' -- REPORT |
|---|---|
| 4/27 | Location |
| 5/5 | 8" @ 1092' w/500<br>Anhy 1089'<br>Drlg. 3148' |
| 5/12 | Heeb 3350', Br li 3421', KC 3434',<br>Arb. 3715'<br>DST 3715-21', 1 hr., 20' M & sulp wtr. 780#<br>RTD 3777'<br>5" @ 3768' |
| 5/19 | WOCT. |
| 6/2 | Spud 4-26-54 Oil well TD 3777<br>8" @ 1092 Anhy 1089 Heeb 3350<br>Br. lime 3421 KC 3434 Arb. 3715<br>DST 3715-21 open 1 hr rec 20' mud & sul. wtr. 780# TD 3777 5" @ 3768<br>DST 3763-68 open 1 hr rec 60' gas, 25' mud 50#<br>DST 3768-77 open 1 hr rec 135' mud & GCO, 5' sul. wtr. 680# CO to 3777<br>S/14 BOPD 15 GW 500 A<br>P/2 BOPH Comp. 40 BOPD |

**COMPLETED**

DX-78

FORM 275 FOR SALE BY KANSAS BLUE PRINT CO.

County Rush State Kansas

Sec. 33 (Blk. Twp.) 19 (Sur. Rge.) 16W Map No.

Operator Alkay Oil of Tulsa

Well No. 2 Farm Nagle

Elev. Location NW SE NE

990 Ft. From S Line NE Quarter

990 Ft. From E Line

1st. Report APR 27 1954

Completion

Remarks

Duke & Wood - Contr.

Spudding Date

FIRST REPORT

Drlg. Data Ryan Pool

Location

J. G. McGEHEE

FORM 275 FOR SALE BY KANSAS BLUE PRINT CO.

County Rush State Kansas

Sec. 33 (Blk. Twp.) 19 (Sur. Rge.) 16W Map No.

Operator Alkay Oil of Tulsa

Well No. 2 Farm Nagle

Elev. 2030 Location NW SE NE

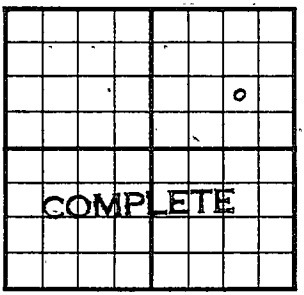


990 Ft. From S Line NE

990 Ft. From E Line Quarter

1st. Report

Completion JUN 2 1954

Remarks Ryan Pool

Duke & Wood - Contr.

Spudding Date 4-26-54

Drlg. Data Oil well TD 3777

8" @ 1092 Anhy 1089 Heeb. 3350

Br. lime 3421 KC 3434 Arb. 3715

DST 3715-21 open 1 hr. Rec. 20' mud &

sul. wtr. 780# TD 3777 5" @ 3768

DST 3763-68 open 1 hr. Rec. 60' gas

25' mud 50# DST 3768-77 open 1 hr.

Rec. 135' mud & gco 5' sul. wtr. 680#

CO to 3777 S/.14 bopd 15 gw 500 A

P/ 2 boph. Comp. 40 bopd

J. G. McGEHEE