

Rush

KANSAS

SECTION 33 TOWNSHIP 19 RANGE 16 W


WELL NO. #1 Tammen "A"

COMPANY Ben Brack Oil

NORTH

WEST

EAST

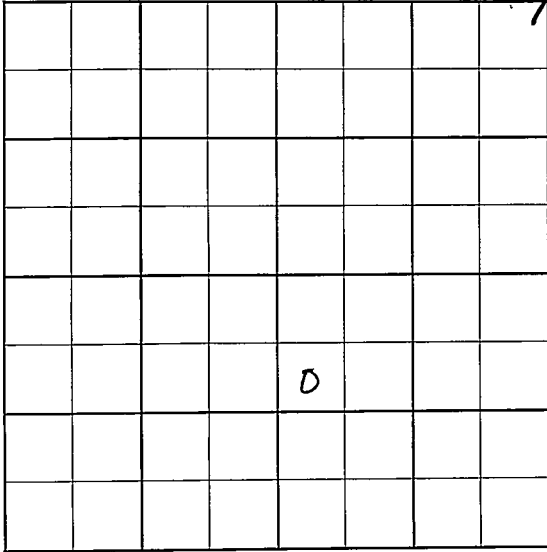

SOUTH

Rush

KANSAS

SEC.	TWP.	R.
33	19	16W

WELL NO.

#1 Tammen "A"

FARM

COMPANY

Ben Brack Oil

CONTRACTOR

Co. Tools

_____ Ft. from N. Line	NORTH
_____ Ft. from S. Line	
_____ Ft. from E. Line	
_____ Ft. from W. Line	

SW NW SE

Magnolia - Fo

1955	ELEVATION 2043'	REPORT
------	--------------------	--------

10/26

R U R

1956

1-18

Comm. 11-3-55

8 5/8" @ 775/400

DST 3441-49 op 1 hr. rec. 150' sw,
1050/20"

DST 3725-37 op 1/2 hr. gas in 2 min.

1,100 mcfg rec 40' gcm, 445#

5 1/2" @ 3781/100

CO to 3792, 2 1/2 bw, 16 hrs., 250 A

S/ 1/2 bfph, 30% oil, 1500 A

S/ 1 3/4 bfph 70% wtr., 24/ 3777-81

PB 3779

S/ 4 1/2 bf 1 hr. 50% oil

P/ 2.77 bo, 50% wtr., 24 hrs.

Comp. 5 bopd 60% wtr.

H. 3359

BL 3429

L. 3441

A. 3724

TD 3792'

COMPLETED

County Rich Elev. _____
 Sec. 33 Twp. 19 Rge. 16W
 Company Ben Brack Oil
 FarmName Tammen "A" No. 1

TOPS	DEPTH	LOG	DATUM
Anh.			
Tp.			
H.			
Tr.			
Dg.			
Bl.			
L.			
K.C.			
B.K.C.			
Ce.			
C.			
M.			
M.			
K.			
Mz.			
Mq.			
V.			
S.			
S.			
A.			
R.			
PE.			
G.			
T.D.			

Loc. in Sec. SW NW SE


Geol. _____

Contr. Co. tools

Pool _____

FIRST REPORT
 OCT 26 '55

Date Comm. Magnolia FO
RUR

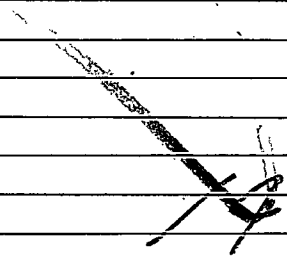

Co.
Lsc.
No.
Sec.
T.
R.

County	Rush	Elev.	2043	Co.	
Sec.	33	Twp.	19		
Company	Ben Brack Oil		Rge.		16W
Farm Name	Tammen "A"		No.		1

TOPS	DEPTH	LOG	DATUM	Loc. in Sec.
Anh.				SW NW SE
Tr.				
H.	3359			
Dg.				
Bl.	3429			
L.	3441		1378	Geol.
K.C.				Contr.
B.K.C.				Co. tools
Ce.				Pool
C.				
M.				
M.				
K.				
Mz.				
Ma.				
V.				
S.				
S.				
A	3724		1681	COMPLETE
R.				
Pe.				
G.				
T.D.	3792			

Date Comm.	11-3-55	JAN 18 1956
8 5/8" @ 775/400	DST 3441-49	open 1 hr
rec. 150' sw	1050/20" DST 3725-37	
open 1/2 hr.	gas in 2 min.,	1,100 mcfg
rec. 40' gcm	445#	5 1/2" @ 3781/100
CO to 3792	2 1/2 bw	16 hr. 250 A
S/ 1/2 bfph	30% oil	1500 A
S/ 1 3/4 bfph	70% wtr.	24/ 3777-81
PB 3779	S/ 1 1/2 bf	1 hr. 50% oil

OVER

P/ 2.77 bo 50% wtr. 24 hr.

Comp. 5 bopd 60% wtr.

R. G.

JAN 27 1956