

Rush

FORM 252-B

KANSAS ✓

Sec. 33 Twp. 19 R. 16W

Well No. #2Tannen Farm

Ben Brack Company

Contractor


Ft. from N. Line

330 Ft. from S. Line

Ft. from E. Line

330 Ft. from W. Line

SW SW SE

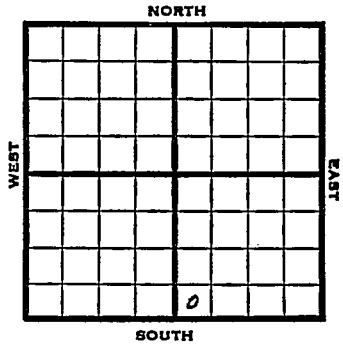

1953 Elev. 2028' REPORT

6/3 Loc.

6/10 8" @ 1075 Anhy 1069
Drlg. 1790'

6/24 RTD 3760'
5" @ 3759'
Arb 3709'

7/1 N.R.

7/8 "

7/22 "

8/5 Spud 6-4-53
Oil Well
TD 3760'
8" @ 1075'
Anhy 1069, Arb 3709,
TD 3760'
5" @ 3759'
DST 3732-37 opn 3/4 hr, 1,630,000 gas
20' gcm
DST 3747-60 opn 1/2 hr, gas in 4 min
2,700,000 gas 75' ocm 970#
DST 3737-47 opn 25 min, 2,130,000 gas
30' gcm 690#
DD 3767 S/ 46 bo 12 bw 6 hr.
Comp. 40 bopd 10 bw.

COMPLETED

