

KANSAS

Rush



Sec. 33 Twp. 19 R. 16W

Well No. #2 Tammen Farm

Magnolia Company


990 Ryan
Ft. from N. Line

_____ Ft. from S. Line

330
Ft. from E. Line

_____ Ft. from W. Line

SE NE SE

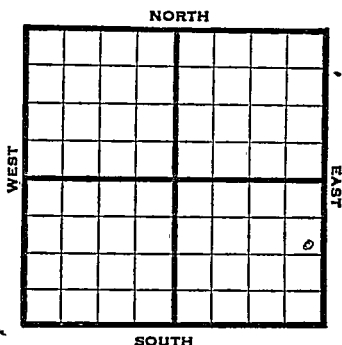

1947

Elev. 2021' REPORT

9/10 Location

9/17 "

9/24 "

10/1 Surface hole.

10/8 8" @ 1073'
Drlg. 2230'

10/15 Lansing 3418'
Arbuckle 3736'
TD 3763'
Run 5"

10/22 5" @ 3761'
TD 3765'
500 acid

11/5 Arbuckle 3736'
5" @ 3761'
1500 Acid
Pump 15 oil & 25% W Pot.
Total Depth 3765'
Gr. 37°

COMPLETED

Map No. _____ Sec. 33 Twp. 19 R. 16W

Well No. 2 Tammen

Magnolia Company

FIRST REPORT Contractor

SE NE SE

SECTION PLAT

990 Ft. from N. Line

_____ Ft. from S. Line

330 Ft. from E. Line

_____ Ft. from W. Line

Rush County

Location X

Rig up _____

Drilling and Remarks:

RECORD

Cased _____ in, _____ ft.

Sand _____

Gas _____

Oil _____

Total Depth _____

PRODUCTION

1st 24 hrs. Nat. _____

1st 24 hrs. after shot _____

Gas _____ Cu. Ft.

Dry Hole _____

Abandoned _____

Date

SEP 10 1947

19

S. J. LEWIS

Scout

Ryan Pool

Form 26 200 Bks. 10-46 Petrol

Kansas

Map No. 81 Sec. 33 Twp. 19 R. 16W

Well No. 2 Tammen

Magnolia Company

COMPLETE

Contractor

SE NE SE

E. 1, 2, 3, 4
SECTION PLAT

990 Ft. from N. Line

 Ft. from S. Line

330 Ft. from E. Line

 Ft. from W. Line

Rush County

Location

Rig up

Drilling and Remarks:

Cell # 8736
5" @ 274.
1500 @ 274
Pump 15 oil + 25%
W.P.D.
27 = 27

RECORD

Cased in., ft.

Sand

Gas

Oil

Total Depth 276.5

PRODUCTION

1st 24 hrs. Nat.

1st 24 hrs. after shot

Gas Cu. Ft.

Dry Hole

Abandoned

Date

NOV 5 1947 19

S. J. LEWIS

Scout