


KANSAS

Barton county

Section 34 Township 19 Range 11-W

Well No. #2, Brenn

Company Hershey Est. et al

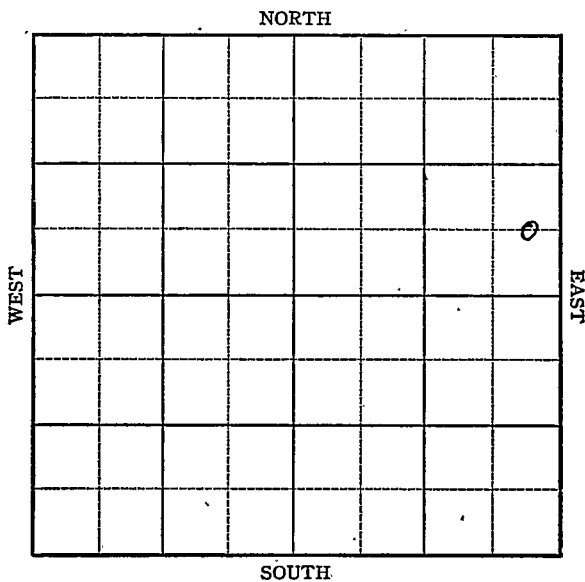

Sec. 34 Twp. 19 R. 11W

Well No. #2 Brenn Farm _____
Hershey EST. etal Company _____


Silica

_____ Ft. from N. Line

660 Ft. from S. Line

330 Ft. from E. Line

_____ Ft. from W. Line

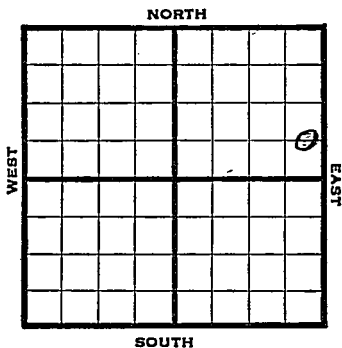

C E L SE NE.

1946 Elev. 1773' REPORT

8/28 8" @ 170'
1165'

9/5 Lans 3044
Arb 3305'
TD 3312
5" @ 3308 RUST

9/10 " "

9/18 Swb 75 oil a day

9/24 " "

10/1 " "

10/8 " "

10/15 " "

10/23 Arb 3305'
5" @ 3308'
TD 3312'
Pump 48 oil plus 60 W POT
Grav. 42

COMPLETED

KANSAS

Kansas Pool Name SilicaMap No. 46 Sec. 34 Twp. 19 R. 11WWell No. 2 BrennHershey Est. etal. Company

FIRST REPORT

Contractor

C E L S E N E

SECTION PLAT

 Ft. from N. Line660 Ft. from S. Line330 Ft. from E. Line Ft. from W. Line

			o

Barton County

Location Rig up

Drilling and Remarks:

8" @ 170'

1165'

RECORD

Cased in., ft.Sand Gas Oil Total Depth

PRODUCTION

1st 24 hrs. Nat. 1st 24 hrs. after shot Gas Cu. Ft.Dry Hole Abandoned

Date

AUG 28 1946 19

S. J. LEWIS Scout

KANSAS

Map No. 46 Sec. 34 Twp. 19 R. 11W

Well No. 2 Brenn

Hershey Est. etal. Company

COMPLETED

Contractor

C E L S E N E

E. 1773

SECTION PLAT

 Ft. from N. Line
660 Ft. from S. Line
330 Ft. from E. Line
 Ft. from W. Line

			o

Barton County

Location

Rig up

Drilling and Remarks:

Cor 2305
5" 2308.
Pump. 48 oil +
60 1/2 2

42 2/2

RECORD

Cased in., ft.
Sand
Gas
Oil
Total Depth 2312

PRODUCTION

1st 24 hrs. Nat.
1st 24 hrs. after shot
Gas Cu. Ft.
Dry Hole
Abandoned

Date

OCT 23 1946 19

S. J. LEWIS Scout