

# KANSAS


FORM 51 5M PETROL

Barton

Section 34 Township 19 Range 11-W

Well No. #1 Brenn

Company J. H. Hershey

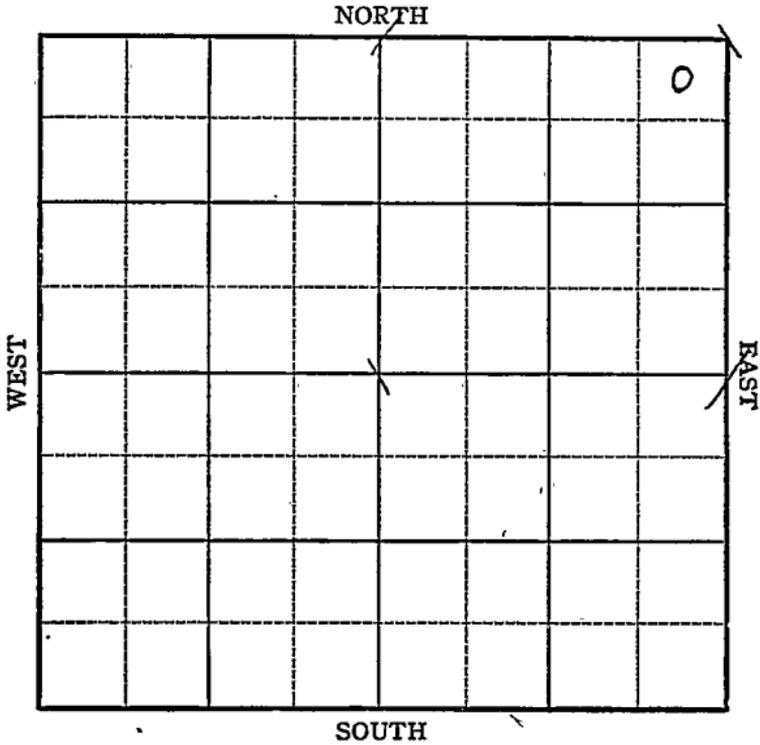

Sec. 34 Twp. 19 R. 11-W

Well No. #1 Brenna Farm

J. H. Hershey Company


330 Ft. from N. Line

\_\_\_\_\_ Ft. from S. Line

330 Ft. from E. Line

\_\_\_\_\_ Ft. from W. Line

Elev. 1773

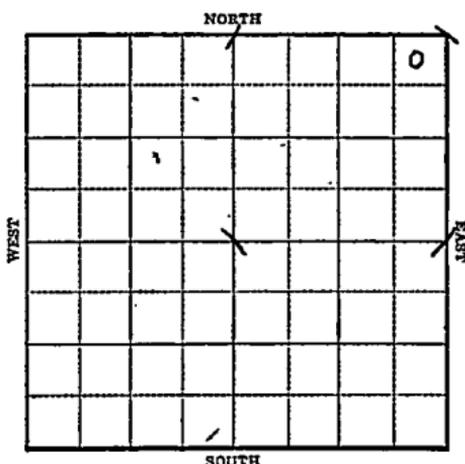

1943

R E P O R T

10/27 Rotary

11/3 8" @ 182  
Anhy. 508  
Drlg. 1820'

11/10 Arb 3341 Drlg.

11/17 Cong 3341 corrected No Arb.  
5" @ 3170  
TD 3429 in Cong.  
SD 3078-88 in Lans.

11/24 " "

12/1 73 shots 3073-85 1000 Acid

12/8 5" @ 3170

Cong 3341  
T.D. 3429  
1000 acid  
Water

ABANDONED

KANSAS

Map No. 46 Sec. 34 Twp. 19 R. 11WWell No. 1 BrennJ. H. Hershey

Company

FIRST REPORT

Contractor

NE/C

330

Ft. from N. Line

Ft. from S. Line

330

Ft. from E. Line

Ft. from W. Line

## SECTION PLAT


Silica Pool

Location \_\_\_\_\_

Rig up \_\_\_\_\_

Drilling and Remarks:

Rotary

## RECORD

Cased \_\_\_\_\_ in., \_\_\_\_\_ ft.

Sand \_\_\_\_\_

Gas \_\_\_\_\_

Oil \_\_\_\_\_

Total Depth \_\_\_\_\_

## PRODUCTION

1st 24 hrs. Nat. \_\_\_\_\_

1st 24 hrs. after shot \_\_\_\_\_

Gas \_\_\_\_\_ Cu. Ft.

Dry Hole \_\_\_\_\_

Abandoned \_\_\_\_\_

Date

OCT 27 1943

19

S. J. LEWIS Scout

Map No. KANSAS 86 Sec. 34 Twp. 19 R. 11W

Well No. I Brenn

J. H. Hershey Company

ABANDONED Contractor

NE/C

330 Ft. from N. Line

\_\_\_\_\_ Ft. from S. Line

330 Ft. from E. Line

\_\_\_\_\_ Ft. from W. Line

SECTION PLAT

			0

Silica Pool

Location \_\_\_\_\_

Rig up \_\_\_\_\_

Drilling and Remarks:

*Cong 3341*  
*5-6 @ 3170.*  
*3429 in Cong.*  
*1000 add*  
*Water*

RECORD

Cased \_\_\_\_\_ in., \_\_\_\_\_ ft.

Sand \_\_\_\_\_

Gas \_\_\_\_\_

Oil \_\_\_\_\_

Total Depth 3429

PRODUCTION

1st 24 hrs. Nat. \_\_\_\_\_

1st 24 hrs. after shot \_\_\_\_\_

Gas \_\_\_\_\_ Cu. Ft.

Dry Hole \_\_\_\_\_

Abandoned \_\_\_\_\_

Date

DEC 8, 1943 19

S. J. LEWIS Scout