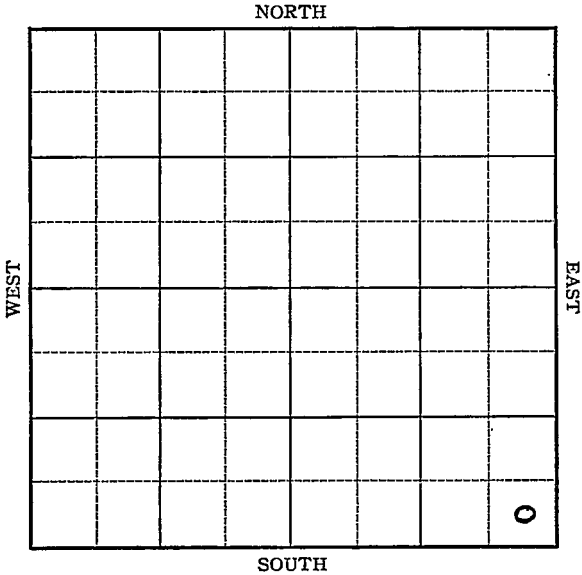


Barton

Section 34 Township 19 Range 11-WWell No. 1 *ROSE Schartz*
~~Schartz "B"~~Company Stanolind

1938

3/2

6" @ 3302'.

Arb. 3300'.

T.D. 3310'.

2500 acid.

Potential 457 bbls.

COMPLETED

Barton KANSAS


Map No. _____ Sec. 34 Twp. 19 R. 11WWell No. 1 Scharitz "B"_____Stanolind_____ Company_____
Contractor

FIRST REPORT

SE/C

Ft. from N. Line330
Ft. from S. Line330
Ft. from E. Line_____
Ft. from W. Line

SECTION PLAT

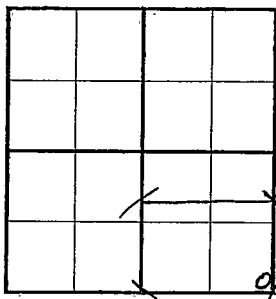

Location _____

Rig up _____

Drilling and Remarks:

RUR

RECORD

Cased _____ in., _____ ft.

Sand _____

Gas _____

Oil _____

Total Depth _____

PRODUCTION

1st 24 hrs. Nat. _____

1st 24 hrs. after shot _____

Gas _____ Cu. Ft.

Dry Hole _____

Abandoned _____

Date

JAN 26 1938 19 H. D. Hatfield Scout

Returned

Cards

Tracing

France Map

Scarborough Map

Moody Map

Scarborough Flat Book

Moody Flat Book

Barton KANSASMap No. _____ Sec. 34 Twp. 19 R. 11 WWell No. 1- Rose SchartzStanlund Company

Contractor

CORRECTION

SECTION PLAT

_____ Ft. from N. Line

330 Ft. from S. Line330 Ft. from E. Line

_____ Ft. from W. Line

			0

Location _____

RECORD

Cased _____ in., _____ ft.

Sand _____

Gas _____

Oil _____

Total Depth _____

Drilling and Remarks:

*first reported
as 1- Schartz "B"*

PRODUCTION

1st 24 hrs. Nat. _____

1st 24 hrs. after shot _____

Gas _____ Cu. Ft.

Dry Hole _____

Abandoned _____

Date

FEB 9 1933 19 E. D. Hatfield Scout

June.

Returned _____
Cards _____ *Paul*
Tracing _____ *June*
France Map _____
Scarborough Map _____ *June*
Moody Map _____
Scarborough Plat Book _____
Moody Plat Book _____

Barton KANSAS

Map No. _____ Sec. 34 Twp. 19 R. 11WWell No. 1 Rose Schartz

Stanolind

Company

Contractor

COMPLETED

SE/C

SECTION PLAT

			0

_____ Ft. from N. Line

330 Ft. from S. Line330 Ft. from E. Line

_____ Ft. from W. Line

Location _____

Rig up _____

Drilling and Remarks:

2500 Acid
POT 457

RECORD

Cased 6 in., 3302 ft.Sand Ark 3300

Gas _____

Oil _____

Total Depth 3310

PRODUCTION

1st 24 hrs. Nat. _____

1st 24 hrs. after shot _____

Gas _____ Cu. Ft.

Dry Hole _____

Abandoned _____

Date

MAR 2 - 1938 19

H. D. Hatfield Scout

RAJ

Returned	
Cards	Paul
Tracing	Jim
France Map	RAJ
Scarborough Map	RAJ
Moody Map	
Scarborough Plat Book	
Moody Plat Book	