

KANSAS

Rice


Form 51-5M-7-39-Palace

Section 34 Township 19 Range 10-W

Well No. #4 Gum

Company Continental

NORTH Chase Pool

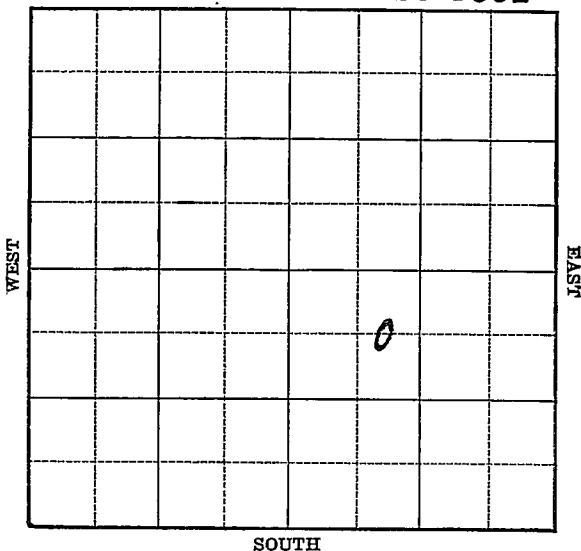

Map No. F6 Sec. 34 Twp. 19 R. 10WWell No. 4 GumContinental

Company

Contractor

FIRST REPORT

SECTION PLAT

C E L N W S E

660 Ft. from N. Line

_____ Ft. from S. Line

_____ Ft. from E. Line

990 Ft. from W. Line

		o	

CHASE POOL

Location _____

Rig up _____

Drilling and Remarks:

Moving in
Rotary Tools

RECORD

Cased _____ in., _____ ft.

Sand _____

Gas _____

Oil _____

Total Depth _____

PRODUCTION

1st 24 hrs. Nat. _____

1st 24 hrs. after shot _____

Gas _____ Cu. Ft.

Dry Hole _____

Abandoned _____

Date

MAY 1 1940₉

S. J. LEWIS

Scout

Misc Small Maps *BM*
Cards *BM*
Tracing *BM*
France Map *BM*
Scarborough Map *BM*
Moody Map *BM*
Geological Dept.
Moody Flat Eock

Map No. 46 Sec. 34 Twp. 19 R. 10W

Well No. 4 Gum

Continental

Company

Contractor

COMPLETED

C E L N W S E

660 Ft. from N. Line

_____ Ft. from S. Line

_____ Ft. from E. Line

990 Ft. from W. Line

SECTION PLAT

CHASE POOL

Location _____

Rig up _____

Drilling and Remarks:

Cr 83296
7" @ 3297
1000 @ 3306
Pump 449 P.Y.

RECORD

Cased _____ in., _____ ft.

Sand _____

Gas _____

Oil _____

Total Depth 3309

PRODUCTION

1st 24 hrs. Nat. _____

1st 24 hrs. after shot _____

Gas _____ 'Cu. Ft.

Dry Hole _____

Abandoned _____

Date

MAY 29 1940

S. J. LEWIS Scout

Misc, Small Maps.....
Cards.....
Tracing.....
France Map.....
Scarborough Map.....
Moody Map.....
Geological Dept.
Moody Flat Book

Handwritten signatures and scribbles in cursive script, overlapping the printed text.