


Section.....34.....Township.....19.....Range.....10-W

Well Number.....1 Hathaway.....

Company.....Texas.....

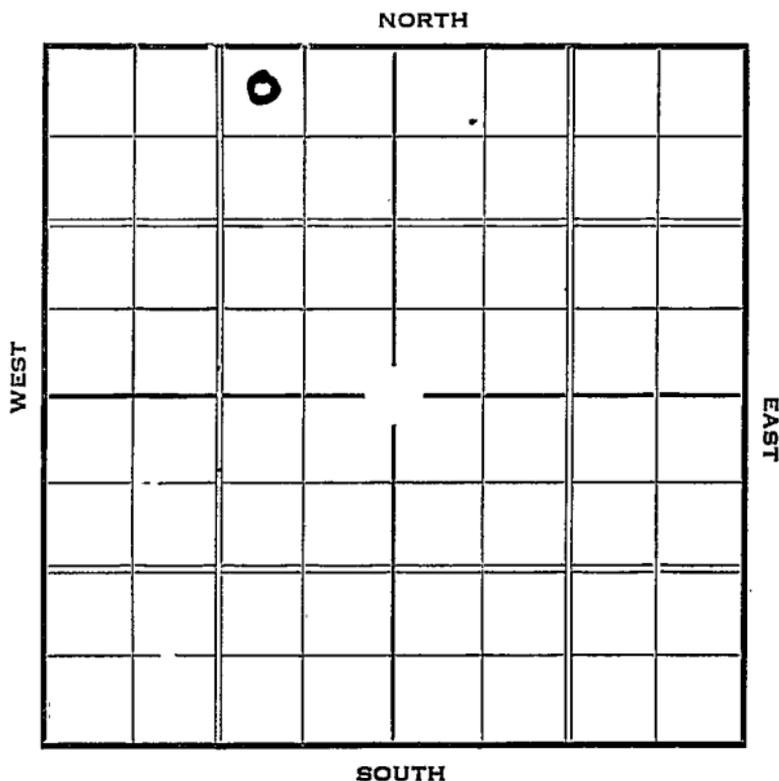

1937

6/2

7" @ 3306'.

Sil. 3302'.

T.D. 3325'.

425' water 6 hrs.

P.B. 3306'.

1000 acid.

ABANDONED

KANSAS Rice

Map No. _____ Sec. 34 Twp. 19 R. 10WWell No. 1 HathawayTexas Company

Contractor _____

SECTION PLAT

	0		

330 Ft. from N. Line

_____ Ft. from S. Line

990 Ft. from E. Line

_____ Ft. from W. Line

FIRST REPORT

Location ✓

Rig up _____

Drilling and Remarks:

RECORD

Cased _____ in., _____ ft.

Sand _____

Gas _____

Oil _____

Total Depth _____

PRODUCTION

1st 24 hrs. Nat. _____

1st 24 hrs. after shot _____

Gas _____ Cu. Ft.

Dry Hole _____

Abandoned _____

Date

APR 7 1937 19

S. J. LEWIS Scout

Returned _____

Cards _____ *Paul*

Tracing _____ *John*

France Map _____ *[Signature]*

Scarborough Map _____ *[Signature]*

Moody Map _____

Scarborough Plat Book _____

Moody Plat Book _____

Paul

Rice **KANSAS**Map No. 46 Sec. 34 Twp. 19 R. 10 WWell No. 1 - Hathaway
Texas Company

Contractor

ABANDONED

SECTION PLAT

	0		

330 Ft. from N. Line

_____ Ft. from S. Line

990 Ft. from E. Line

_____ Ft. from W. Line

Location _____

Rig up _____

Drilling and Remarks:

425' water - 6' oil

P.B. 3306

1000 Acid

D + A

RECORD

Cased 7 in., 3306 ft.Sand Si 1 3302

Gas _____

Oil _____

Total Depth 3325

PRODUCTION

1st 24 hrs. Nat. _____

1st 24 hrs. after shot _____

Gas _____ Cu. Ft.

Dry Hole _____

Abandoned _____

Date

JUN 2 1937 19

H. D. Hatfield

Scout

1

✓
✓
Rally

Returned
Cards
Tracing
France Map
Scarborough Map
Moody Map
Scarborough Plat Book
Moody Plat Book