

# KANSAS

Form 51-5M-7-39-Palace


Rice

Section 34 Township 19 Range 10-W

Well No. #2 Hathaway

Company Rose & Son

NORTH Chase Pool

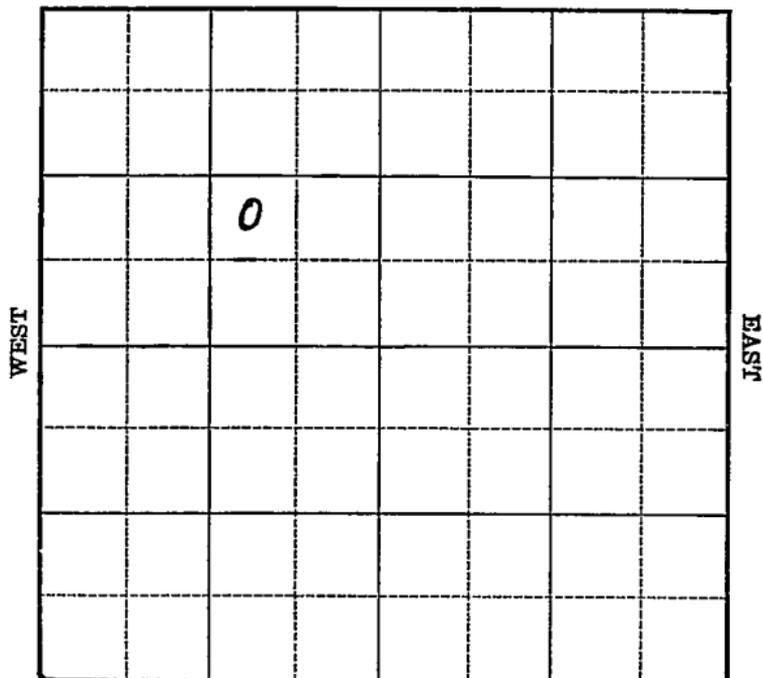

SOUTH



1940  
3/13

Arb. 3311'  
5" - 3311'  
T.D. 3317'

Potential 102 bbls. on pump.

**COMPLETED**



Misc. Small Maps

Cards

Tracing

France Map

Scarborough Map

Moody Map

Geological Dept.

Moody Plat Book

Map No. 46 Sec. 34 Twp. 19 R. 10W

Well No. 2 Hathaway

Rose & Son Company

Contractor

**COMPLETED**

**SECTION PLAT**

NW SE NW

\_\_\_\_\_ Ft. from N. Line

990 Ft. from S. Line

990 Ft. from E. Line

\_\_\_\_\_ Ft. from W. Line


**CHASE POOL**

Location \_\_\_\_\_

Rig up \_\_\_\_\_

Drilling and Remarks:

*Cr 43311*

*5" @ 3311*

*Port 102 Pump.*

**RECORD**

Cased \_\_\_\_\_ in., \_\_\_\_\_ ft.

Sand \_\_\_\_\_

Gas \_\_\_\_\_

Oil \_\_\_\_\_

Total Depth 3317

**PRODUCTION**

1st 24 hrs. Nat. \_\_\_\_\_

1st 24 hrs. after shot \_\_\_\_\_

Gas \_\_\_\_\_ Cu. Ft.

Dry Hole \_\_\_\_\_

Abandoned \_\_\_\_\_

Date

MAR 13 1940 19

S. J. LEWIS Scout

Misc. Small Maps .....  
Cards .....  
Tracing .....  
France Map .....  
Scarborough Map .....  
Moody Map .....  
Geological Dept. ....  
Moody Flat Book .....

*[Handwritten signatures and initials over the list items]*