


Section 34 Township 19 Range 10-W

Well Number #2-Kleile

Company Texas

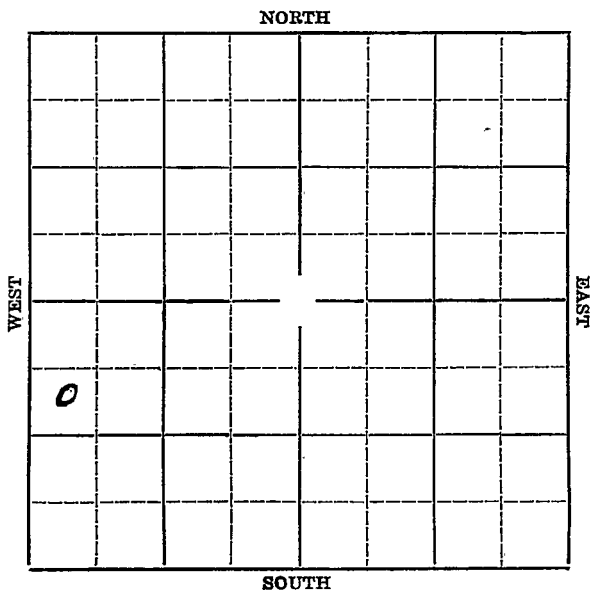

Map No. KANSAS Sec. 34 Twp. 19 R. 10W

Well No. #2 Kleile Farm

The Texas Company. Company


990' Ft. from N. Line

_____ Ft. from S. Line

_____ Ft. from E. Line

330' Ft. from W. Line

Elev. 1782

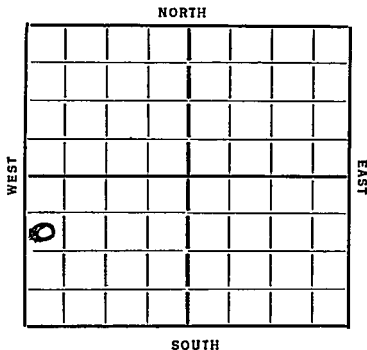

| Date | REPORT |
|---------|---|
| 1936 | |
| 8/5 | Location |
| 8/13 | Ream 500 same. |
| 8/20 | -- |
| 8/27 | Rig. |
| 9/3 | 12" @ 148'. Drlg. 1900'. |
| | |
| 9/23/36 | -Sil. 3315'. |
| | T.D. 3326'. |
| | 1000 gallons of acid. |
| | Potential 1100 gallons of bbls |
| | of oil in 22½ hours. |
| | |
| | |
COMPLETED

KANSAS

Map No. 46 Sec. 34 Twp. 19 R. 10WWell No. 2 MilesTexaco Company

Contractor

SECTION PLAT

| | | | |
|---|--|--|--|
| | | | |
| | | | |
| 0 | | | |
| | | | |

990 Ft. from N. Line

_____ Ft. from S. Line

_____ Ft. from E. Line

330 Ft. from W. Line

FIRST REPORT

Location ✓

Rig up _____

Drilling and Remarks:

RECORD

Cased _____ in., _____ ft.

Sand _____

Gas _____

Oil _____

Total Depth _____

PRODUCTION

1st 24 hrs. Nat. _____

1st 24 hrs. after shot _____

Gas _____ Cu. Ft.

Dry Hole _____

Abandoned _____

Date

AUG 5 1936

19

S. J. LEWIS Scout

[Large handwritten signature]

| | |
|-----------------------|--------------------|
| Returned | <i>[Signature]</i> |
| Cards | <i>[Signature]</i> |
| Tracing | <i>[Signature]</i> |
| France Map | <i>[Signature]</i> |
| Scarborough Map | <i>[Signature]</i> |
| Moody Map | <i>[Signature]</i> |
| Scarborough Plat Book | |
| Moody Plat Book | |

Map No. 46 Sec. 34 Twp. 19 R. 10WWell No. 2 HeileTexas

Company

Contractor

SECTION PLAT

| | | | |
|---|--|--|--|
| | | | |
| | | | |
| | | | |
| 0 | | | |
| | | | |

990 Ft. from N. Line

_____ Ft. from S. Line

_____ Ft. from E. Line

330 Ft. from W. Line

COMPLETED

Location _____

Rig up _____

Drilling and Remarks:

Oil 3315-1000 acidP 8 110022 1/2 hrs

RECORD

Cased _____ in., _____ ft.

Sand _____

Gas _____

Oil _____

Total Depth 3326

PRODUCTION

1st 24 hrs. Nat. _____

1st 24 hrs. after shot _____

Gas _____ Cu. Ft.

Dry Hole _____

Abandoned _____

Date

SEP 23 1936₁₉S. J. LEWIS Scout

[Large handwritten signature]

| | |
|-----------------------|--------------------|
| Returned | <i>[Signature]</i> |
| Cards | <i>[Signature]</i> |
| Tracing | <i>[Signature]</i> |
| France Map | <i>[Signature]</i> |
| Scarborough Map | <i>[Signature]</i> |
| Moody Map | <i>[Signature]</i> |
| Scarborough Flat Book | |
| Moody Plat Book | |