


Section 34 Township 19 Range 10-W

Well Number 7 Kleile

Company Texas

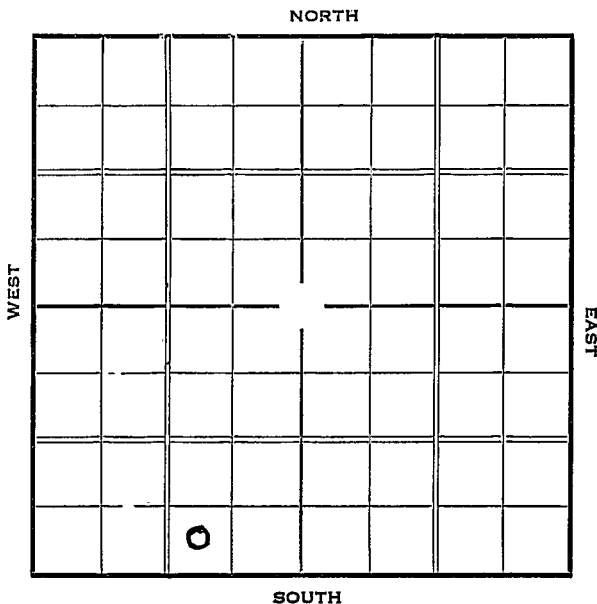

Sec. 34 Twp. 19 R. 10-W

Well No. #7 Kleile Farm

Texas Company


 Ft. from N. Line

330 Ft. from S. Line

990 Ft. from E. Line

 Ft. from W. Line

Elev. 1781

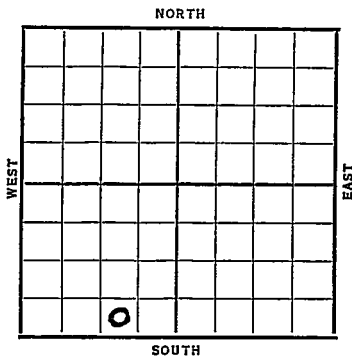

Date	REPORT
1937	
4/7	Rig
4/16	Rigging up
4/23	10" @ 190'. Drlg. 1520'.
4/30	Drlg. 2955'.
5/7	Sil. 3314'. 7" @ 3314'.
	T.D. 3317'. RUST.
5/14	Bailing.
5/19	7" @ 3314'.
	Sil. 3314'.
	T.D. 3326'.
	1000 acid.
	Potential 2362 bbls.
	COMPLETED

KANSAS *Rice*

Map No. _____ Sec. 34 Twp. 19 R. 10W

Well No. 7 Meile

Texas Company

Contractor _____

SECTION PLAT

_____ Ft. from N. Line

230 Ft. from S. Line

990 Ft. from E. Line

_____ Ft. from W. Line

FIRST REPORT

Location _____

Rig up _____

Drilling and Remarks:

Rig

RECORD

Cased _____ in., _____ ft.

Sand _____

Gas _____

Oil _____

Total Depth _____

PRODUCTION

1st 24 hrs. Nat. _____

1st 24 hrs. after shot _____

Gas _____ Cu. Ft.

Dry Hole _____

Abandoned _____

Date

APR 7 1937 19

S. J. LEWIS Scout

Rice KANSAS

Map No. 46 Sec. 34 Twp. 19 R. 10^wWell No. 7-KleileTexas Company

Contractor

COMPLETED

SECTION PLAT

_____ Ft. from N. Line

530 Ft. from S. Line990 Ft. from E. Line

_____ Ft. from W. Line

	0		

Location _____

RECORD

Cased 7 in., 33/4 ft.Sand 511 33/4

Gas _____

Oil _____

Total Depth 3326

Drilling and Remarks:

1000 acidPot. - 2362

PRODUCTION

1st 24 hrs. Nat. _____

1st 24 hrs. after shot _____

Gas _____ Cu. Ft.

Dry Hole _____

Abandoned _____

Date

MAY 19 1937 19

H. D. Hatfield Scout.