


Rice **KANSAS**
Range **10W**

Section 34 Township 19

Well No. #1 Hathaway

Company Dozier Oil

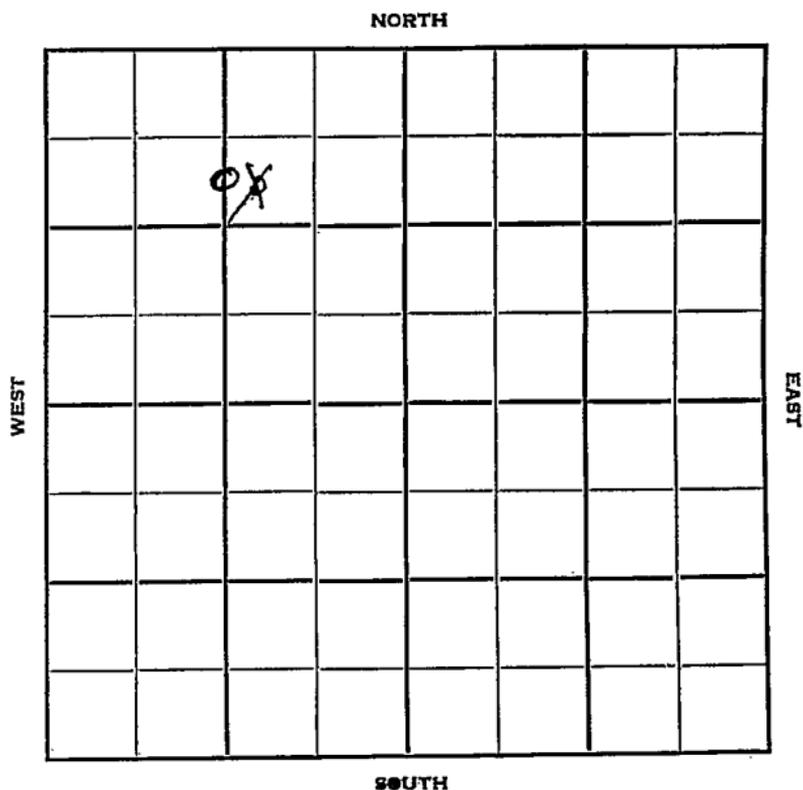

Sec. 34 Twp. 19 R. 10-W ✓

Well No. #1 Hathaway Farm

Dozier Oil Company

Stagg Drlg. Contractor


Silica

990 Ft. from N. Line

_____ Ft. from S. Line

_____ Ft. from E. Line

~~1380~~ 1320 Ft. from W. Line

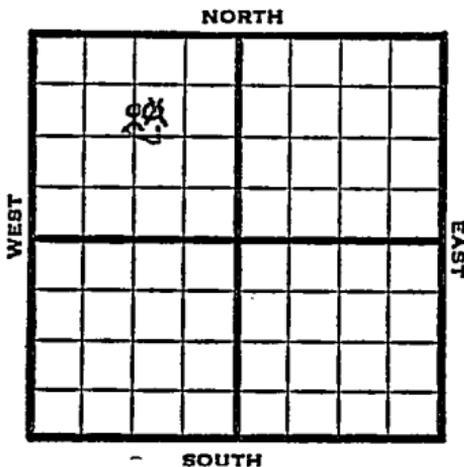

~~SW NE NW~~

C S L N/2 NW

1950 Elv. 1768' REPORT

12/13 RUR

1951
1/3

Spud 12-12-50
 Oil Well TD 3324
 8" @ 300' Anhy 449-60
 Br Lime 2978 Lans. 3006
 DST 3213-21 opn 1hr Rec. 90'
 o& gcm 60' mud & wtr
 Cong. 3307 DST 3308-15 opn 1 hr
 Rec. 1200' gas 690' oil
 Arb. 3320-24 5½" @ 3321 TD 3324
 S/3 boph Comp. 40 bopd

COMPLETE


County Rice State Kansas

Sec. 34 (Blk. Twp.) 19 (Sur. Rq̄.) 10W Map No.

Operator Dozier Oil

Well No. 1 Farm Hathaway

Elev. _____ Location SW NE NW

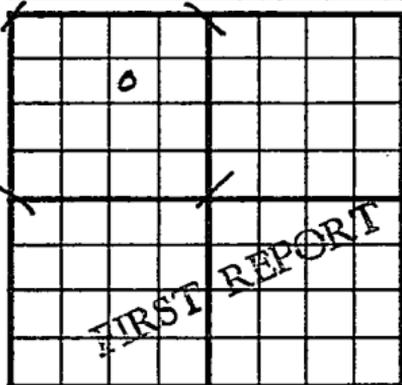

990 Ft. From N Line NW

1380 Ft. From W Line Quarter

Ist. Report DEC 13 1950

Completion _____

Remarks _____

Stagg Drlg. - Contr.

Spudding Date _____

Drlg. Data Silica Pool

R U R

Scout Cards	7 w

DEC 15 1950

Orig. Data

Kansas

Map No. _____ Sec. 34 Twp. 19 R. 10W

Well No. 1 Hathaway

Dozier Oil

Company

CORRECTION

Contractor

C S L N/2 NW


SECTION PLAT

990 Ft. from N. Line

_____ Ft. from S. Line

_____ Ft. from E. Line

1320 Ft. from W. Line

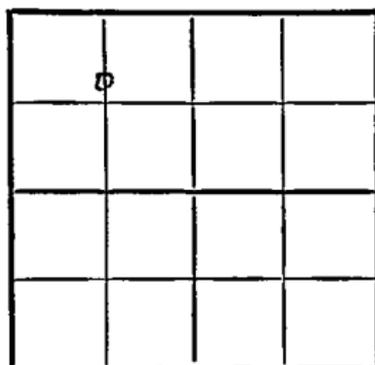

Rice County

Location _____

Rig up _____

Drilling and Remarks:

Reported

SW NE NW

RECORD

Cased _____ in., _____ ft.

Sand _____

Gas _____

Oil _____

Total Depth _____

PRODUCTION

1st 24 hrs. Nat. _____

1st 24 hrs. after shot _____

Gas _____ Cu. Ft.


Dry Hole _____

Abandoned _____

Date

DEC 9 7 1950 19

J. E. TYRA Scout

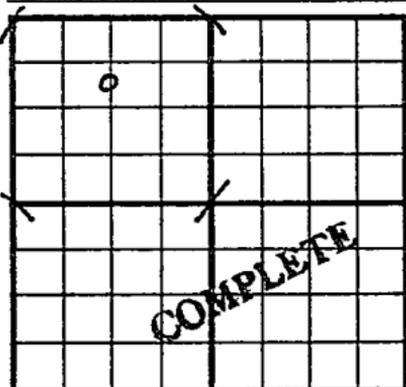County Rice State KansasSec. 34 (Blk.) 19 (Sur.) 10W Map No.Operator Dozier OilWell No. 1 Farm HathawayElev. 1768 Location C S L $N\frac{1}{2}$ NW990 Ft. From N Line NW1320 Ft. From W Line Quarter

1st. Report

Completion JAN 3 1951Remarks Silica PoolStagg Drlg. - Contr.Spudding Date 12-12-50Drlg. Data Oil well TD 33248" C 300 Anhy 449-60 Br. line 2978Lans. 3006 DST 3213-21 open 1 hr.Rec. 90' o & gcm 60' mud & waterCong. 3307 DST 3308-15 open 1 hr.Rec. 1200' gas 690' oil Arb. 3320-244 $\frac{1}{2}$ " @ 3321 TD 3324 S/ 3 bonh.Comp. 40 bopd

J. E. TYRA

1951

Scout Cards
Land Small Map
Land Wall Map (5)
Tracings
Fence Map
P. rice Map
Misc.