


Section 34 Township 19 Range 10-W

Well Number 5 Kleile

Company Texas

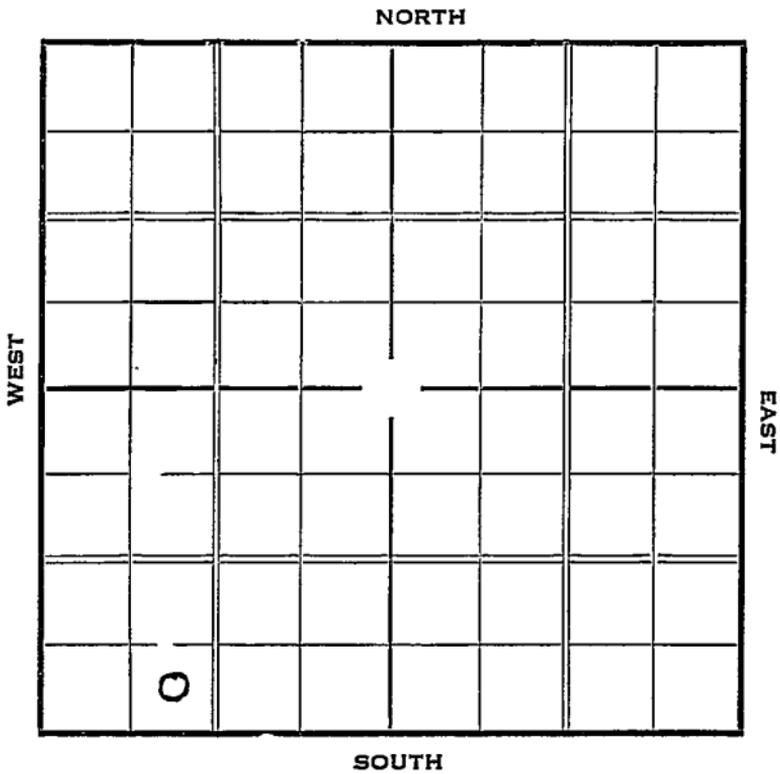

Sec. 34 Twp. 19 R. 10-W

Well No. #5 Kleile Farm

Texas Company


 Ft. from N. Line

330 Ft. from S. Line

 Ft. from E. Line

990 Ft. from W. Line

Elev. 1795

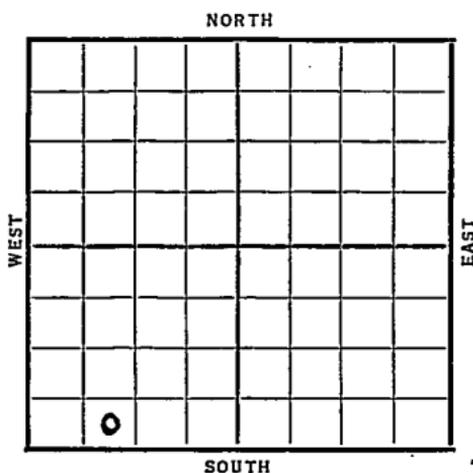

Date	REPORT
1937	
2/17	Rig
2/26	12" @ 195'. Drlg. 1715'.
3/4	Drig. 2740'
3/11	Sil 3323'. Set 7" RUST
3/18	Sil 3323'. Set 7" RUST
3/25	Pump 686 bbls. 19 hrs.
	T. D. 3333'.
3/31	Sil. 3323'.
	T.D. 3333'.
	1000 acid.
	Potential 1501! 12% water.
	COMPLETED

Map No. 46 Sec. 34 Twp. 19 R. 10W

Well No. 5 Meile

Texas Company

Contractor

SECTION PLAT

0			

_____ Ft. from N. Line

320 Ft. from S. Line

_____ Ft. from E. Line

990 Ft. from W. Line

FIRST REPORT

Location _____

Rig up _____

Drilling and Remarks:

Rig

RECORD

Cased _____ in., _____ ft.

Sand _____

Gas _____

Oil _____

Total Depth _____

PRODUCTION

1st 24 hrs. Nat. _____

1st 24 hrs. after shot _____

Gas _____ Cu. Ft.

Dry Hole _____

Abandoned _____

Date

FEB 17 1937

19

S. J. LEWIS

Scout

KANSAS *Rice*

Map No. _____ Sec. 34 Twp. 19 R. 10W

Well No. 5 Kleile

Texas

Company _____

Contractor _____

SECTION PLAT

_____ Ft. from N. Line

330 Ft. from S. Line

_____ Ft. from E. Line

990 Ft. from W. Line

COMPLETED

Location _____

Rig up _____

Drilling and Remarks:

Sil 3323
1000 acid
Potential
1501 - 12% water

RECORD

Cased _____ in., _____ ft.

Sand _____

Gas _____

Oil _____

Total Depth 3323

PRODUCTION

1st 24 hrs. Nat. _____

1st 24 hrs. after shot _____

Gas _____ Cu. Ft.

Dry Hole _____

Abandoned _____

Date

MAR 3 1 1937 19

S. J. LEWIS

Scout