


Rice

Section 34 Township 19 Range 10-W

Well No. 8 - Kleile

Company Texas

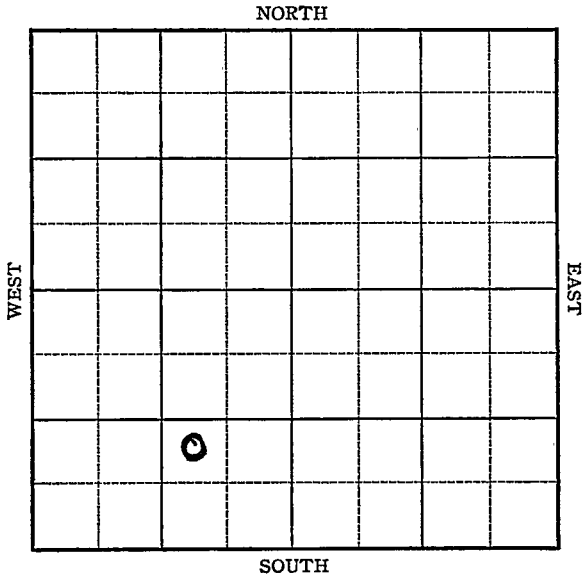



Map No. \_\_\_\_\_ Sec. 34 Twp. 19 R. 10<sup>w</sup>Well No. S-KleileTexas Company

Contractor

## FIRST REPORT

## SECTION PLAT

\_\_\_\_\_ Ft. from N. Line

990 Ft. from S. Line990 Ft. from E. Line

\_\_\_\_\_ Ft. from W. Line

	o	-	-

Location \_\_\_\_\_

Rig up \_\_\_\_\_

Drilling and Remarks:

Rign Rat,

## RECORD

Cased \_\_\_\_\_ in., \_\_\_\_\_ ft.

Sand \_\_\_\_\_

Gas \_\_\_\_\_

Oil \_\_\_\_\_

Total Depth \_\_\_\_\_

## PRODUCTION

1st 24 hrs. Nat. \_\_\_\_\_

1st 24 hrs. after shot \_\_\_\_\_

Gas \_\_\_\_\_ Cu. Ft.

Dry Hole \_\_\_\_\_

Abandoned \_\_\_\_\_

Date

MAY 26 1937 19H. D. Hatfield

Scout

Rice KANSAS

Map No. 46 Sec. 34 Twp. 19 R. 10 <sup>W</sup>Well No. 8-KleileTexas Company

Contractor

COMPLETED

SECTION PLAT

\_\_\_\_\_ Ft. from N. Line

990 Ft. from S. Line990 Ft. from E. Line

\_\_\_\_\_ Ft. from W. Line

	0		

Location \_\_\_\_\_

Rig up \_\_\_\_\_

Drilling and Remarks:

*Pat*  
*1132 / 2 # 1/2"*

*Down 2 hrs*

## RECORD

Cased 7 in., 3316 ft.Sand 511 3315

Gas \_\_\_\_\_

Oil \_\_\_\_\_

Total Depth 3327

## PRODUCTION

1st 24 hrs. Nat. \_\_\_\_\_

1st 24 hrs. after shot \_\_\_\_\_

Gas \_\_\_\_\_ Cu. Ft.

Dry Hole \_\_\_\_\_

Abandoned \_\_\_\_\_

Date

JUN 23 1907/19H. D. Hatfield Scout