


Rice

KANSAS

Section.....34.....Township.....19.....Range.....10-W.....


Well Number.....9 - Kleile.....

Company.....Texas.....

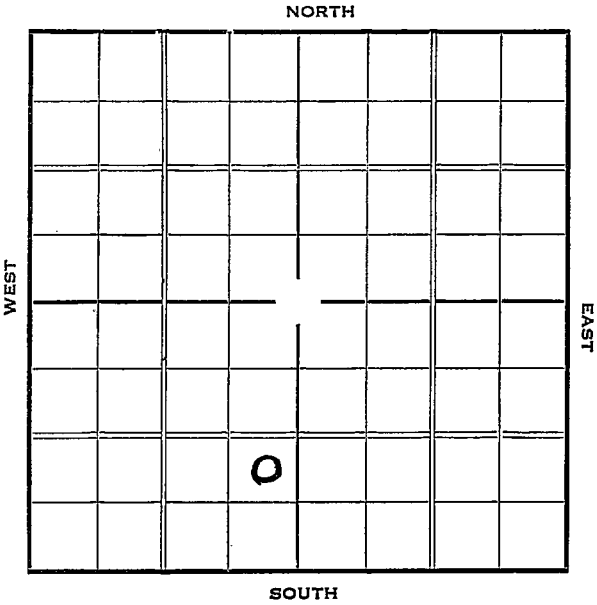

Sec. 34 Twp. 19 R. 10-WWell No. #9 Kleile FarmTexas Company Ft. from N. Line990 Ft. from S. Line330 Ft. from E. Line Ft. from W. Line

Elev. 1776

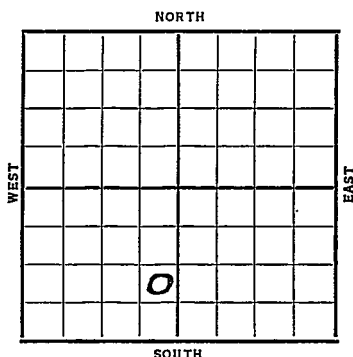

Date	REPORT
1937	
9/15	Cellar
9/24	12" @ 225'. Drlg. 1258'.
10/2	Drlg. 2846'.
10/8	Sil. 3307'. 7" @ 3308'.
	T.D. 3310'. RUST.
	No shows reported.
10/15	T.D. 3314'. Swb. 257 B.O. in
	6 hrs. 1000 acid.
10/21	7" @ 3308'.
	Sil. 3307'.
	T.D. 3314'.
	1000 acid.
	Pump 441 bbls. 4 hrs & 436
	bbls. 4 hours.
	Potential 2617 bbls.
	COMPLETED

Rice KANSAS

Map No. _____ Sec. 34 Twp. 19 R. 10^WWell No. 9-KleileTexas Company

Contractor

FIRST REPORT

SECTION PLAT

	0		

_____ Ft. from N. Line

990 Ft. from S. Line330 Ft. from E. Line

_____ Ft. from W. Line

Location _____

Rig up _____

Drilling and Remarks:

Cellar

RECORD

Cased _____ in., _____ ft.

Sand _____

Gas _____

Oil _____

Total Depth _____

PRODUCTION

1st 24 hrs. Nat. _____

1st 24 hrs. after shot _____

Gas _____ Cu. Ft.

Dry Hole _____

Abandoned _____

Date

SEP 15 1937₁₉H. D. Hatfield Scout

KANSAS

Rice

Map No. 46 Sec. 34 Twp. 19 R. 10WWell No. 9 KleileTexas

Company

Contractor

COMPLETED

NE SE SW

 Ft. from N. Line990 Ft. from S. Line330 Ft. from E. Line Ft. from W. Line

SECTION PLAT

	0		

Location Rig up

Drilling and Remarks:

1000 Acid.P-44 1/4 & 436/4POT-2617

RECORD

Cased 7 in., 3308 ft.Sand 511 3307Gas Oil Total Depth 3314

PRODUCTION

1st 24 hrs. Nat. 1st 24 hrs. after shot Gas Cu. Ft.Dry Hole Abandoned

Date

OCT 20 1937₁₉H. D. Hatfield Scout