


Rice KANSAS.

Section 34 Township 19 Range 10-W

Well No. 11 Kleile

Company Texas

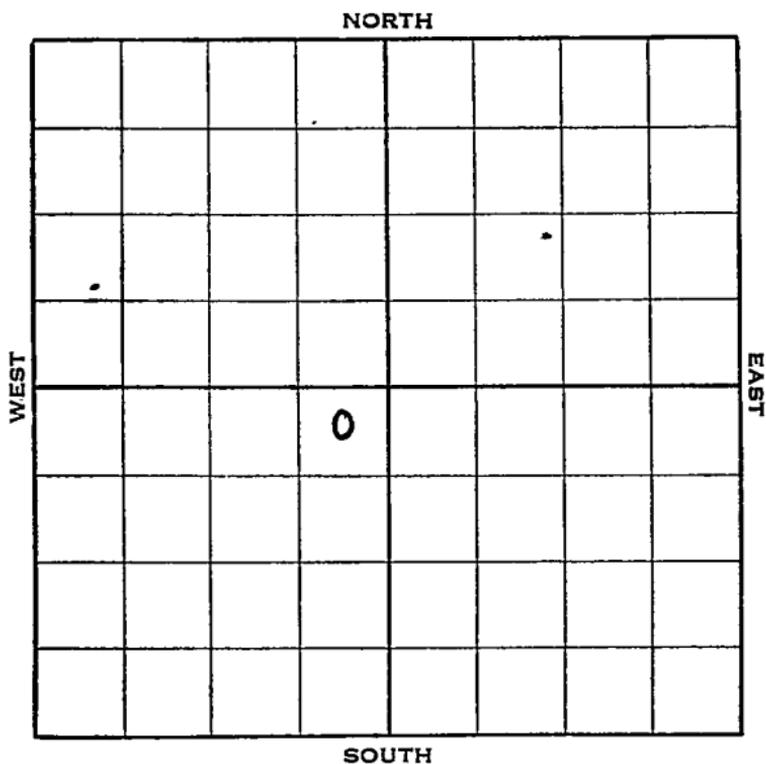

KANSAS

Rice

Sec. 34 Twp. 19 R. 10-W

Well No. #11 Kleile Farm _____


Texas Company _____

330 Ft. from N. Line

_____ Ft. from S. Line

330 Ft. from E. Line

_____ Ft. from W. Line

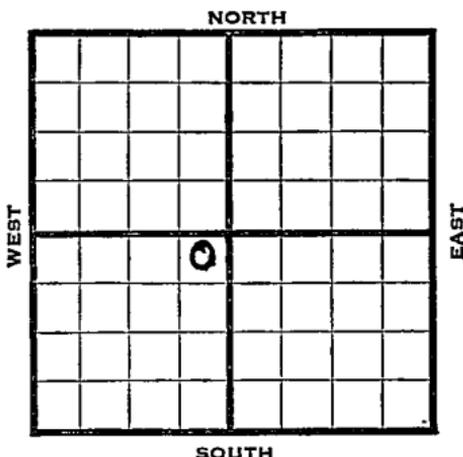

1938	REPORT
8/31	R. R.
9/9	"
9/16	12" - 190'. Dlg. 1469'.
9/23	Dlg. 3012'.
9/30	Cong. 3295'. Arb. 3308'.
	S. O. 3310-20' T.D. 7" - 3308'.
	RUST.
10/5	7" at 3308'.
	Arb. 3308'.
	T. D. 3320'.
	Potential 1200 oil & 300 water.
	COMPLETED

Map No. 46 Sec. 34 Twp. 19 R. 10W

Well No. 11 Kleile

Texas

Company

Contractor

FIRST REPORT

SECTION PLAT

NE SW

330 Ft. from N. Line

_____ Ft. from S. Line

330 Ft. from E. Line

_____ Ft. from W. Line

	0		

Location _____

Rig up _____

Drilling and Remarks:

RR

RECORD

Cased _____ in., _____ ft.

Sand _____

Gas _____

Oil _____

Total Depth _____

PRODUCTION

1st 24 hrs. Nat. _____

1st 24 hrs. after shot _____

Gas _____ Cu. Ft.

Dry Hole _____

Abandoned _____

Date

AUG 31 1938

19

H. D. Hatfield

Scout

Map No. 46 Sec. 34 Twp. 19 R. 10W

Well No. 11 Kleile

Texas

Company

Contractor

COMPLETED

NE SW

330 Ft. from N. Line

_____ Ft. from S. Line

330 Ft. from E. Line

_____ Ft. from W. Line

SECTION PLAT

	0		

Location _____

Rig up _____

Drilling and Remarks:

*POT 1200 oil
300 WTR*

RECORD

Cased 7 in., 3328 ft.

Sand Arb 3208

Gas _____

Oil _____

Total Depth 3320

PRODUCTION

1st 24 hrs. Nat. _____

1st 24 hrs. after shot _____

Gas _____ Cu. Ft.

Dry Hole _____

Abandoned _____

Date

OCT 5 - 1938 19 H. D. Hatfield Scout