

KANSAS

Form 51-5M-11-38-Palace


Rice

Section 34 Township 19 Range 10-W

Well No. #2 McGuire

Company Skelly

NORTH Silica Pool

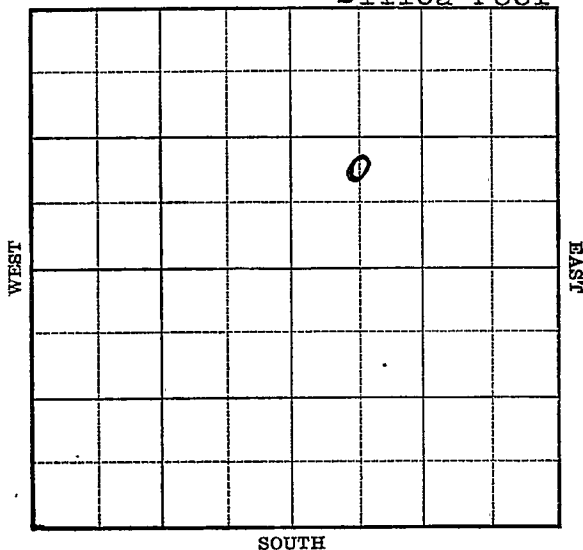

Sec. 34 Twp. 19 R. 10-W

Well No. #2 McGuire Farm

Skelly _____ Company

(Silica)


Ft. from N. Line

990 Ft. from S. Line

Ft. from E. Line

660 Ft. from W. Line

Elev. 1760

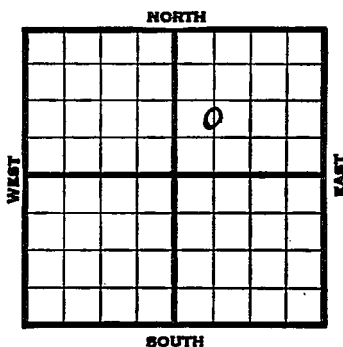[illegible]

Map No. _____ Sec. 34 Twp. 19 R. 10WWell No. 2 McGuireSkelly

Company

Contractor

FIRST REPORT

C N L SW NE

____ Ft. from N. Line

990 Ft. from S. Line

____ Ft. from E. Line

660 Ft. from W. Line

SECTION PLAT

		o	

Silica Pool

Location _____

Rig up _____

Drilling and Remarks: A

10" - 215

WOC

RECORD

Cased _____ in., _____ ft.

Sand _____

Gas _____

Oil _____

Total Depth _____

PRODUCTION

1st 24 hrs. Nat. _____

1st 24 hrs. after shot _____

Gas _____ Cu. Ft.

Dry Hole _____

Abandoned _____

Date

ACT 25 1939 19S J LEWIS

Scout

Map No. 46 Sec. 34 Twp. 19 R. 10WWell No. 2 McGuire

Skel ly

Company

Contractor

~~COMPLETED~~

SECTION PLAT

C N L SW NE

Ft. from N. Line

990 Ft. from S. Line

Ft. from E. Line

660 Ft. from W. Line

SILICA POOL

Location

Rig up

Drilling and Remarks:

*At 3290**5" @ 3291**750 acid**Echometer 28**1278*

RECORD

Cased _____ in., _____ ft.

Sand _____

Gas _____

Oil _____

Total Depth 8297

PRODUCTION

1st 24 hrs. Nat. _____

1st 24 hrs. after shot _____

Gas _____ Cu. Ft.

Dry Hole _____

Abandoned _____

Date

NOV 15 1939

19

S. J. LEWIS

Scout