

KANSAS


Rice

Form 51—5M—7-39—Palace

Section 34 Township 19 Range 10-W

Well No. #3 McGuire

Company Skelly

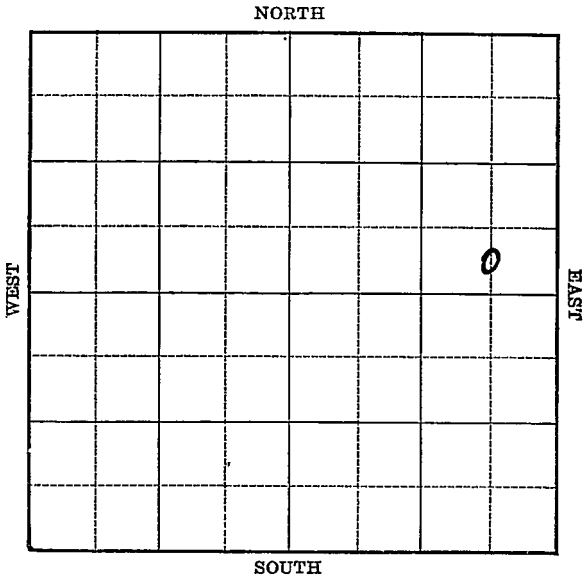

KANSAS


Rice

Sec. 34 Twp. 19 R. 10-WWell No. #3 McGuire FarmSkelly Company

(Chase)

 Ft. from N. Line330 Ft. from S. Line660 Ft. from E. Line Ft. from W. Line

Elev. 1767

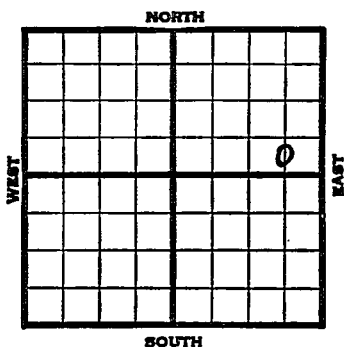

1940	REPORT
1/24	Rotary.
2/1	"
2/8	8" - 316' Drlg. 1423'
2/15	Arb. 3304' T.D. 3308' Sat.
	Run pipe.
2/23	5" - 3306' RUST.
2/29	T.D. 3309' 2800' oil 5 hours.
	1500 acid. Pump 318 bbls. 24
	hours. C. O.
3/6	Arb. 3304'
	5" - 3306'
	T.D. 3309'
	500 acid.
	1000 acid.
	1000 acid.
	Echometer potential 1240 bbls.
	COMPLETED

Rice

KANSAS

Map No. 47 Sec. 34 Twp. 19 R. 10 WWell No. 3 McGuireSkelly Company

Contractor

C S L SE NE

 Ft. from N. Line330 Ft. from S. Line660 Ft. from E. Line Ft. from W. Line

SECTION PLAT

			o

CHASE POOL

Location Rig up

Drilling and Remarks:

Rotary

RECORD

Cased in., ft.Sand Gas Oil Total Depth

PRODUCTION

1st 24 hrs. Nat. 1st 24 hrs. after shot Gas Cu. Ft.Dry Hole Abandoned

Date

JAN 21 1940

19

S. I. LEWIS

Scout

Map No. 46 Sec. 34 Twp. 19 R. 10WWell No. 3 McGuireSkelly

Company

Contractor

COMPLETED

C S L SE NE

 Ft. from N. Line330 Ft. from S. Line660 Ft. from E. Line Ft. from W. Line

CHASE POOL

SECTION PLAT

			0

Location Rig up

Drilling and Remarks:

500 acid
1000 "
1000 "
Echometer 1240
6 bbls

5" C 3306

RECORD

Cased in., ft.Sand *Lurburke 3304*Gas Oil Total Depth *3309*

PRODUCTION

1st 24 hrs. Nat. 1st 24 hrs. after shot Gas Cu. Ft.Dry Hole Abandoned

Date

MAR 6 1940

S. J. LEWIS

Scout