

KANSAS

Rice


Form 51-5M-7-39-Palace

Section 34 Township 19 Range 10-W

Well No. #5 McGuire

Company Skelly

NORTH Chase Pool

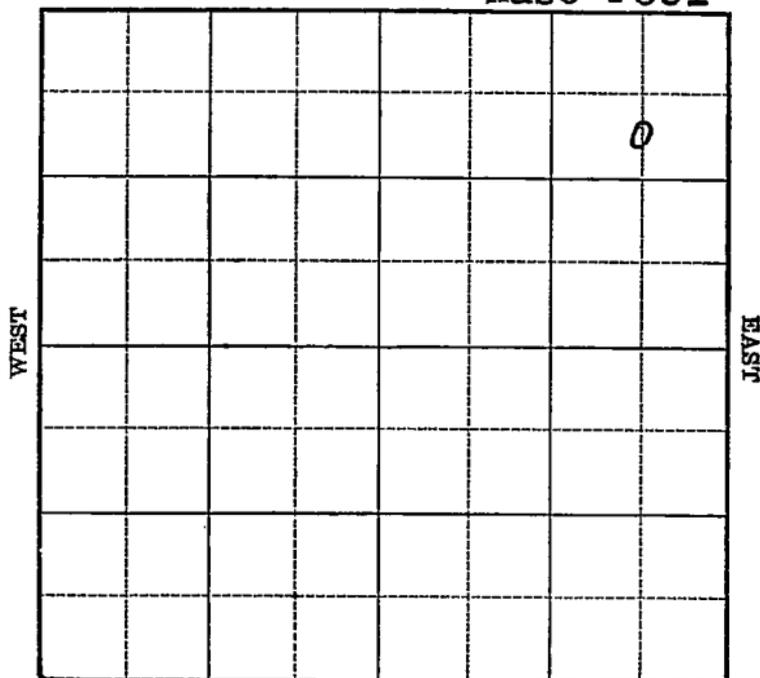

SOUTH

Sec. 34 Twp. 19 R. 10-W

Well No. #5 McGuire Farm

Skelly Company


(Chase)

991 Ft. from N. Line

_____ Ft. from S. Line

660 Ft. from E. Line

_____ Ft. from W. Line

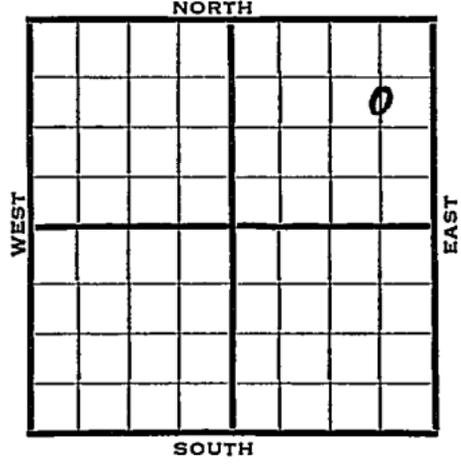

Elev. 1758

1940	REPORT
5/22	Rotary.
5/29	8" - 255' Drlg. 1170'
6/6	Drlg. 3040'
6/13	Arb. 3301' 5" - 330.2'
	T.D. 3306' 800' 2 hours.
6/19	Arb. 3301'
	5" - 3302'
	T.D. 3306'
	3000 acid.
	Pump 19 bbls.
	COMPLETED

Map No. 46 Sec. 34 Twp. 19 R. 10WWell No. 5 McGuireSkelly

Company

Contractor

FIRST REPORT

C S L N E N E

991 Ft. from N. Line

_____ Ft. from S. Line

660 Ft. from E. Line

_____ Ft. from W. Line

SECTION PLAT

			o

CHASE POOL

Location _____

Rig up _____

Drilling and Remarks:

Rotary

RECORD

Cased _____ in., _____ ft.

Sand _____

Gas _____

Oil _____

Total Depth _____

PRODUCTION

1st 24 hrs. Nat. _____

1st 24 hrs. after shot _____

Gas _____ Cu. Ft.

Dry Hole _____

Abandoned _____

Date

MAY 22 1940 19S. J. LEWIS Scout

Map No. 46 Sec. 34 Twp. 19 R. 10WWell No. 5 McGuireSkelly Oil

Company

Contractor

COMPLETED**SECTION PLAT**

C S L NE NE

991 Ft. from N. Line

_____ Ft. from S. Line

660 Ft. from E. Line

_____ Ft. from W. Line

			o

CHASE POOL

Location _____

Rig up _____

Drilling and Remarks:

*Ar 8301**5" @ 3362**3000 acid**Pump 19 lbs***RECORD**

Cased _____ in., _____ ft.

Sand _____

Gas _____

Oil _____

Total Depth 3306**PRODUCTION**

1st 24 hrs. Nat. _____

1st 24 hrs. after shot _____

Gas _____ Cu. Ft.

Dry Hole _____

Abandoned _____

Date

JUN 19 1940 19

S. J. LEWIS Scout