

KANSAS Rice

FORM 51 10M 8-47


Section 34 Township 19 Range 10W

Well No. 6 McGuire

Company Skelly

Silica

NORTH

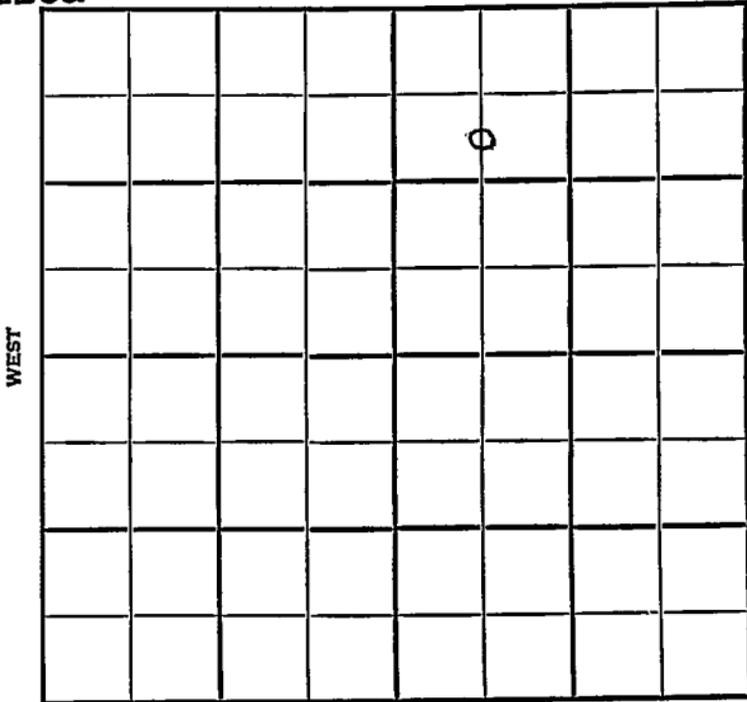

SOUTH

KANSAS Rice

Sec. 34 Twp. 19 R. 10W

Well No. #6 McGuire Farm

Skelly Company


Silica

990 Ft. from N. Line

 Ft. from S. Line

 Ft. from E. Line

660 Ft. from W. Line

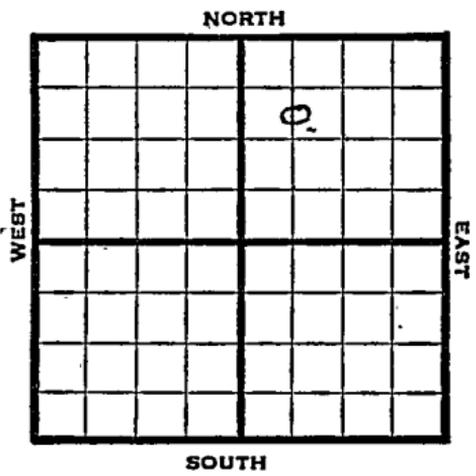

C S L NW NE

1947

Elev. 1759' REPORT

10/15

Location

10/22

"

10/29

"

11/5

8" @ 456'
Drlg. 470'

11/12

8" @ 456'
Lansing 3001'
Arbuckle 3289'
TD 3292'
5" @ 3290'
RUST

11/19

"

11/22

"

12/3

"

12/10

TD 3393' - 250 acid.
Swb. 36 bbls. oil / 13 W in 1 hr.

12/30

Arb. 3289'
5" @ 3290'
Pump 40 oil / 200 W pot 42.0 Gr.
TD 3393'

COMPLETED

Map No. _____ Sec. 34 Twp. 19 R. 10W

Well No. 6 McGuire

Skelly Company

FIRST REPORT

Contractor

C S L NW NE

SECTION PLAT

990 Ft. from N. Line

_____ Ft. from S. Line

_____ Ft. from E. Line

660 Ft. from W. Line

		o	

Rice County

Location X

Rig up _____

Drilling and Remarks:

RECORD

Cased _____ in., _____ ft.

Sand _____

Gas _____

Oil _____

Total Depth _____

PRODUCTION

1st 24 hrs. Nat. _____

1st 24 hrs. after shot _____

Gas _____ Cu. Ft.

Dry Hole _____

Abandoned _____

Date

OCT 15 1947 19

S. J. LEWIS

Scout

Map No. 46 Sec. 34 Twp. 19 R. 10W

Well No. 6 McGuire

Skelly Company

COMPLETE

Contractor

C S L NW NE'

E11259
SECTION PLAT

990 Ft. from N. Line

 Ft. from S. Line

 Ft. from E. Line

660 Ft. from W. Line

Rice County

Location

Rig up

Drilling and Remarks:

Cr 3289
5' @ 3290
Pump 40 oil +
200 W.P.D.

42.0/21

RECORD

Cased in., ft.

Sand

Gas

Oil

Total Depth *3289*

PRODUCTION

1st 24 hrs. Nat.

1st 24 hrs. after shot

Gas Cu. Ft.

Dry Hole

Abandoned

Date

DEC 30 1947 19

S. J. LEWIS

Scout