


Section 34 Township 19 Range 9W

Well No. #2 Mable Sledd

Company Lebsack et al

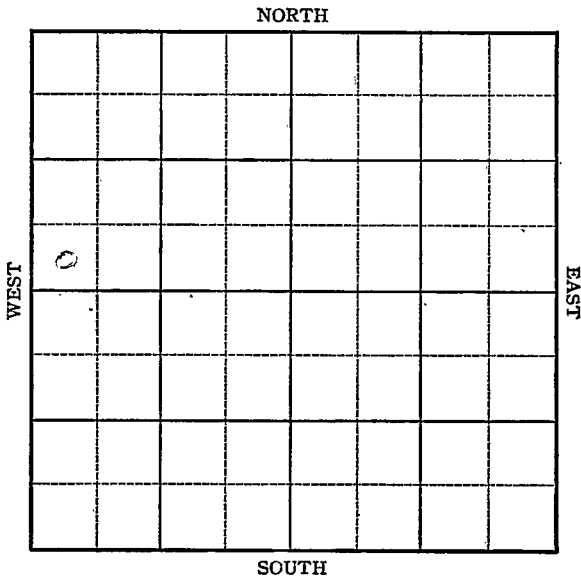

Sec. 34 Twp. 19 R. 9W

Well No. #2 Mable Sledd Farm

Lebsack et al Company

Chase


_____ Ft. from N. Line

330 Ft. from S. Line

_____ Ft. from E. Line

330 Ft. from W. Line

SW NW Elev. 1622

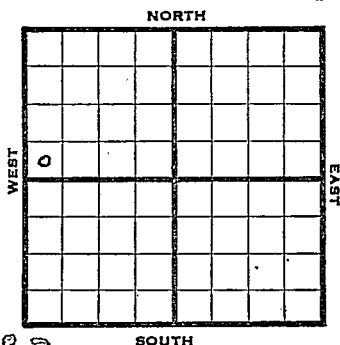

1945

R E P O R T

3/14	13" @ 194	WOC
3/23	Drig. 2690'	
3/29	Lans 2845	
	TD 3202	
	5" @ 3202	RUST
4/5	Arb	3199
4/12	TD 3222	
	26' of 5" perf. liner @ 3222	
	300' oil 68 hrs.	
4/20	" " " " "	" "
4/27	" " " " "	" "
5/3	" " " " "	" "
5/10	" " " " "	" "
5/17	" " " " "	" "
5/24	" " " " "	" "
5/31	" " " " "	" "
6/8	" " " " "	" "
6/14	" " " " "	" "
6/21	" " " " "	" "
6/28	" " " " "	" "
7/11	Arb. 3199	
	7" @ 3202	
	TD 3222	

ABANDONED

Kansas Pool Name Chase

Map No. 79 Sec. 34 Twp. 19 R. 9W

Well No. 2 Mable Sledd

Lebsack etal Company

ABANDONED

Contractor

SW NW

E11682
SECTION PLAT

 Ft. from N. Line

330 Ft. from S. Line

 Ft. from E. Line

330 Ft. from W. Line

Rice County

Location

Rig up

Drilling and Remarks:

CR 3199
7" C3202

RECORD

Cased in., ft.

Sand

Gas

Oil

Total Depth 3222

PRODUCTION

1st 24 hrs. Nat.

1st 24 hrs. after shot

Gas Cu. Ft.

Dry Hole

Abandoned

Date

JUL 1 1945 19

S. J. LEWIS Scout