


Section 34 Township 19 Range 9-W

Well No. #1 sledd

Company Carl Lebsack

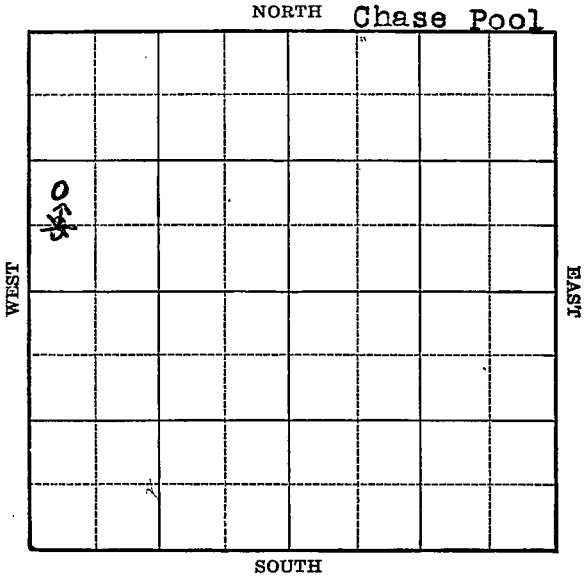

Sec. 34 Twp. 19 R. 9-W

Well No. #1 Sledd Farm

Carl Lebsack Company

(Chase)


\_\_\_\_\_ Ft. from N. Line

990  
~~660~~ Ft. from S. Line

\_\_\_\_\_ Ft. from E. Line

330 Ft. from W. Line

Elev. 1682

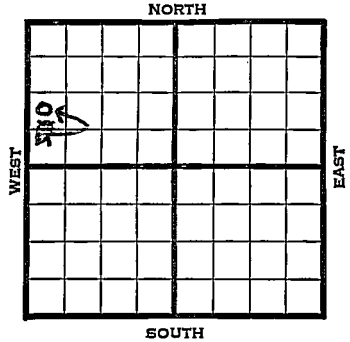

1941	REPORT
2/19	Location
2/27	"
3/6	8" - 203' Drlg. 1470'
3/13	Topeka 2440' Lans. 2850' Drlg. 2891'
3/20	Re-work Arb. 3188' Arb. 3223' 5" - 3220' TD 3232'
	RUST.
3/27	T.D. 3236' 500 acid. Pump 66 oil in 3 hours.
4/2	Arb. 3223' 5" - 3220' T.D. 3236' 500 acid. Potential 28.0 bbls., pump.
	COMPLETED

Map No. 49 Sec. 34 Twp. 19 R. 9WWell No. 1 SleddCarl Lebsack Company~~FIRST REPORT~~ Contractor

C W L SW NW

         Ft. from N. Line660 Ft. from S. Line         Ft. from E. Line330 Ft. from W. Line

CHASE POOL

## SECTION PLAT

0			

Location XRig up         

Drilling and Remarks:

## RECORD

Cased          in.,          ft.Sand         Gas         Oil         Total Depth         

## PRODUCTION

1st 24 hrs.-Nat.         1st 24 hrs. after shot         Gas          Cu. Ft.Dry Hole         Abandoned         

Date

FEB 19 1949 19

S J F.W.S

Scout

Map No. 49 Sec. 34 Twp. 19 R. 9WWell No. 1 SleddCarl Lebsack

Company

CORRECTION

Contractor

## SECTION PLAT

NW SW NW

\_\_\_\_\_ Ft. from N. Line

990 Ft. from S. Line

\_\_\_\_\_ Ft. from E. Line

330 Ft. from W. Line

o			

Chase Pool

Location \_\_\_\_\_

Rig up \_\_\_\_\_

Drilling and Remarks:

Reported

C W L SW NW

## RECORD

Cased \_\_\_\_\_ in., \_\_\_\_\_ ft.

Sand \_\_\_\_\_

Gas \_\_\_\_\_

Oil \_\_\_\_\_

Total Depth \_\_\_\_\_

## PRODUCTION

1st 24 hrs.-Nat. \_\_\_\_\_

1st 24 hrs. after shot \_\_\_\_\_

Gas \_\_\_\_\_ Cu. Ft.

Dry Hole \_\_\_\_\_

Abandoned \_\_\_\_\_

Date

MAR 12 1941 19

S. J. LEWIS Scout

Map No. 49 Sec. 34 Twp. 19 R. 9WWell No. 1 SleddCarl Lebsack Company

Contractor

**COMPLETED****SECTION PLAT**

NW SW NW

\_\_\_\_\_ Ft. from N. Line

990 Ft. from S. Line

\_\_\_\_\_ Ft. from E. Line

330 Ft. from W. Line

o			

CHASE POOL

Location \_\_\_\_\_

Rig up \_\_\_\_\_

Drilling and Remarks:

*Cr 8223**5" 8226**500 acd**Pump 280 Pot.***RECORD**

Cased \_\_\_\_\_ in., \_\_\_\_\_ ft.

Sand \_\_\_\_\_

Gas \_\_\_\_\_

Oil \_\_\_\_\_

Total Depth 8226**PRODUCTION**

1st 24 hrs. Nat. \_\_\_\_\_

1st 24 hrs. after shot \_\_\_\_\_

Gas \_\_\_\_\_ Cu. Ft.

Dry Hole  \_\_\_\_\_

Abandoned: \_\_\_\_\_

Date

APR 2 1941 19

S. J. LEWIS Scout