

KANSAS

FORM 51 5M 10-41 PETROL


Rice

Section 34 Township 19 Range 9-W

Well No. #1 Sledd

Company Carl Lebsack et al.

Chase Pool NORTH

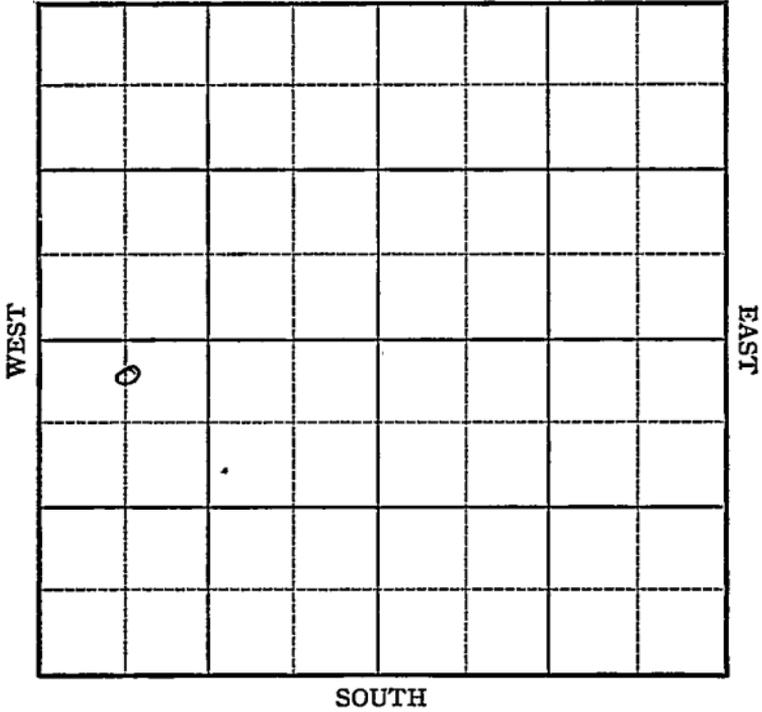

Sec. 34 Twp. 19 R. 9-W

Well No. #1 Sledd Farm

Carl Lebsack et al Company

(Chase Pool)


330 Ft. from N. Line

_____ Ft. from S. Line

_____ Ft. from E. Line

660 Ft. from W. Line

Elev. 1683

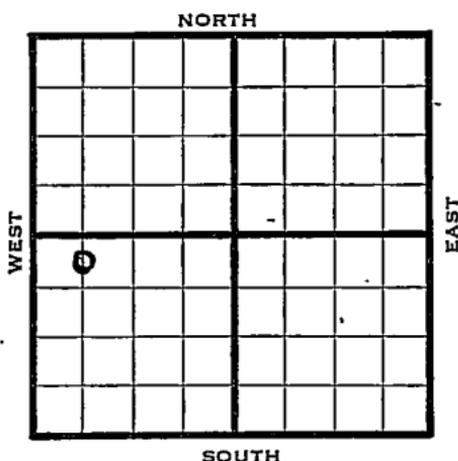

1942	REPORT
8/5	8" 196' Drlg. 1710'
8/12	Lans 2837 Drlg 2969
8/19	No report.
8/27	Arb 3211 5" @ 3211 TD 3222-700' oil 2 hrs.
9/2	T.D. 3230 - 1000 acid. 1800' oil
9/9	750 acid 2000' oil
9/16	" " "
9/23	" " " "
9/30	Lansing 2837 Arbuckle 3211 5" 3211 T.D. 3230 1750 acid Pump 500 bopd plus 2% wtr. 44 grav.
COMPLETED	

Rice

KANSAS

Map No. 49 Sec. 34 Twp. 19 R. 9WWell No. 1 SleddCarl Lebsack et al. Company**FIRST REPORT**

Contractor

C NL NW SW

SECTION PLAT

330 Ft. from N. Line

_____ Ft. from S. Line

_____ Ft. from E. Line

660 Ft. from W. Line

o			

CHASE POOL

Location _____

Rig up _____

Drilling and Remarks:

8"-196'

Drlg. 1710'

RECORD

Cased _____ in., _____ ft.

Sand _____

Gas _____

Oil _____

Total Depth _____

PRODUCTION

1st 24 hrs. Nat. _____

1st 24 hrs. after shot _____

Gas _____ Cu. Ft.

Dry Hole _____

Abandoned _____

Date

AUG 5 1942 19 _____S. J. LEWIS Scout

Misc. Small Maps

Cards

Tracing

France Map

Scarborough Map

Moody Map

Geological Dept.

Moody Plat Book

KANSAS

Map No. 49 Sec. 34 Twp. 19 R. 9W

Well No. 1 Sledd

Carl Lebsack etal. Company

Contractor

C NL NW SW

SECTION PLAT

330 Ft. from N. Line

_____ Ft. from S. Line

_____ Ft. from E. Line

660 Ft. from W. Line

⊙			

CHASE POOL

Location _____

Rig up _____

Drilling and Remarks:

1750 Acid

Pump 500 Bopd

Plus 2% Wfr.

44 g fav

RECORD

Cased 5 in., 3211 ft.

Sand _____

Gas _____

Oil _____

Total Depth 3230

PRODUCTION

1st 24 hrs. Nat. _____

1st 24 hrs. after shot _____

Gas _____ Cu. Ft.

Dry Hole _____

Abandoned _____

Date **COMPLETED**

SEP 30 1942 19

S. I. LEWIS Scout

Lansing 2837
Arbuckle 3211

Misc. Small Maps	25
Cards	25
Tracing	25
France Map	25
Scarborough Map	25
Moody Map	25
Geological Dept.	
Moody Flat Book	