


Section 34 Township 19 Range 9 W

Well No. # 1 Sledd

Company Don Ingling et al

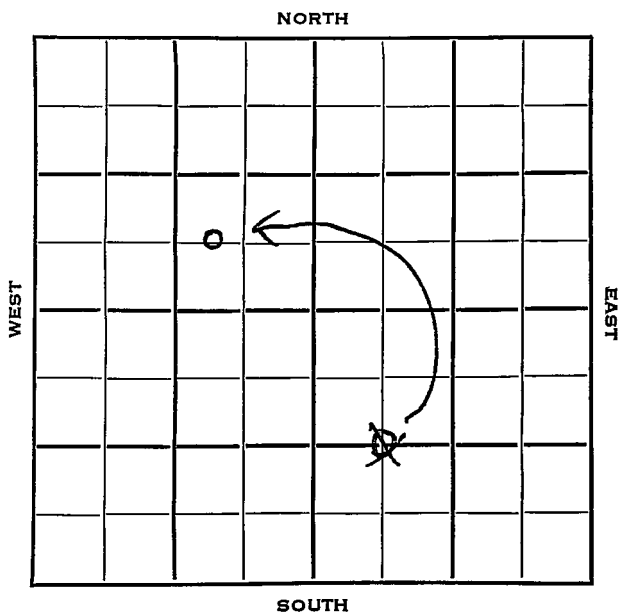

Sec. 34 Twp. 19 R. 9W

Well No. #1 Sledd Farm

Don Ingling et al Company

Ingling Contractor  
Chase Pool

Ft. from N. Line

660

Ft. from S. Line

~~1320~~

Ft. from E. Line


990

Ft. from W. Line

~~660~~

C W L SE NW

~~C W 1/2 SE~~

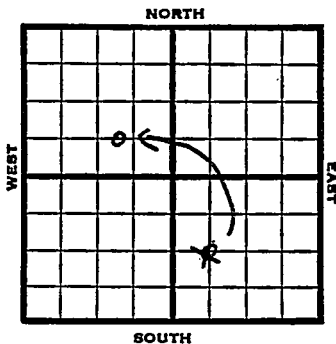

1952 Elev. 1682' REPORT

12/3 Location

12/11 8" @220 Anhy 695 Ø1980

Lans 2854 Ø 3118

12/25 Lans 2854 Drlg 3118

1/1 Arb 3682 RTD 319 1/4 5" @ 3188

1/8 CO 319 1/4 FU 300' Oil DD 3198 2000A  
DD 3210 TD FU 600' Oil Tub & Rock

1/22 NR

1/29 DD 3233 TD 600' oil

2/5 NR

2/12 P/16 BOPD plus 30% wtr. 500 A

2/19 NR

2/25 Spud 12-3-52 Oil well TD 3210  
8" @ 220 Anhy 695 Heeb 2698  
Lans. 2854 B. Penn 3171 Arb. 3182  
DST 3185-9/4 open 1 hr. rec 10' clean  
oil, 55' HOCM 500# TD 319 1/4  
5" @ 3188 CO to 319 1/4 FU 300' oil  
DD 3198 2000 A DD 3210 FU 600'  
oil P/16 BOPD 30% wtr. 500 A  
Comp. 15 BOPD 30% wtr.

**COMPLETED**


County **Rice** State **Kansas**

Sec. **34** (Blk. Twp.) **19** (Sur. Rge.) **9W** Map No.

Operator **Don Ingling etal.**

Well No. **1** Farm **Sledd**

Elev. Location **C W  $\frac{1}{2}$  SE**

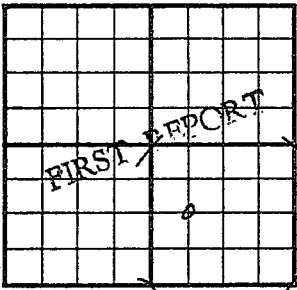

**1320** Ft. From **S** Line **SE**

**660** Ft. From **W** Line Quarter

Ist. Report **DEC 3 1952**

Completion

Remarks

**Ingling - Contr.**

Spudding Date

Drlg. Data **Chase Pool**

**Location**

Scout Cards \_\_\_\_\_ *AB*  
Land Small Map \_\_\_\_\_  
Land Wall Map \_\_\_\_\_ *B*  
Tracings .....  
France Map .....  
Pierce Map .....  
Misc. \_\_\_\_\_

DEC 5 1952

KANSAS

Map No. \_\_\_\_\_ Sec. 34 Twp. 19 R. 9W

Well No. 1 Sledd

Don Ingling Company

CONNECTION Contractor

C W L SE NW

SECTION PLAT

\_\_\_\_\_ Ft. from N. Line

660 Ft. from S. Line

990 Ft. from E. Line

\_\_\_\_\_ Ft. from W. Line


Rice County

Location \_\_\_\_\_

Rig up \_\_\_\_\_

Drilling and Remarks:

Reported

C W  $\frac{1}{2}$  SE

RECORD

Cased \_\_\_\_\_ in., \_\_\_\_\_ ft.

Sand \_\_\_\_\_

Gas \_\_\_\_\_

Oil \_\_\_\_\_

Total Depth \_\_\_\_\_

PRODUCTION

1st 24 hrs. Nat. \_\_\_\_\_

1st 24 hrs. after shot \_\_\_\_\_

Gas \_\_\_\_\_ Cu. Ft.

Dry Hole \_\_\_\_\_

Abandoned \_\_\_\_\_

Date \_\_\_\_\_

DEC 23 1919

J. G. McGEHEE Scout

Scout Cards \_\_\_\_\_  
Land Small Map \_\_\_\_\_  
Land Wall Map \_\_\_\_\_  
Tracings \_\_\_\_\_  
France Map \_\_\_\_\_  
Pierce Map \_\_\_\_\_  
Misc. \_\_\_\_\_

DEC 29 1952

5



MAR 4 1953

Scout Cards	<i>mm</i>
Land Small Map	<i>3</i>
Land Wall Map	
Tracings	
France Map	
Pierce Map	
Misc.	

Orig. Data