
DX 78-1 McPherson **KANSAS**

Section 34 Township 19 Range 2W

Well No. #2 Koehn "B"

Company J. A. Allison

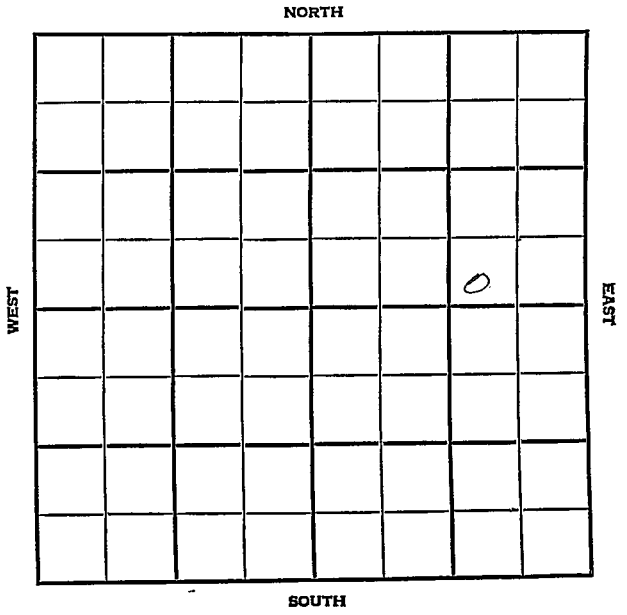

McPherson **KANSAS**

SEC.	TWP.	R.
34 ·	19	2W

WELL NO. #2 Koehn "B" FARM

COMPANY J.A. Allison

CONTRACTOR Cappitt


_____ Ft. from N. Line

_____ Ft. from S. Line

_____ Ft. from E. Line

_____ Ft. from W. Line

SW SE NE

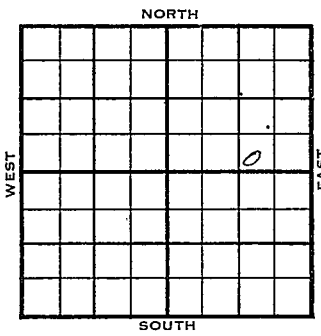

1956	ELEVATION 1548	REPORT
3-21	Comm. 3-17-56 8" @ 164/125 Drlg. 1291	
4-4	5½" @ 2953 CO to 2968, 750 A SP 2947, 24/ 2940-46 CO Comp. 35 bopd M. 2938 TD 2968'	

COMPLETED

DX-78

FORM 513 REV. SUNRAY

County McPherson Elev.

Sec. 34 Twp. 19 Rge. 2W

Company J. A. Allison

Farm Name Koehn "B" No. 2

TOPS	DEPTH	LOG	DATUM
Anh.			
T.P.			
H.			
Tr.			
Dg.			
B.L.			
L.			
K.C.			
B.K.C.			
Ce.			
C.			
M.			
M.			
K.			
Mz.			
Mg.			
V.			
S.			
S.			
A			
R.			
P€.			
G.			
T.D.			

Loc. in Sec. SW SE NE

Geol. ..

Contr. Cappitt

Pool

MAR 21 '56

FIRST REPORT

Date Comm. 3-17-56

8" @ 161/125 drlg. 1291

Co. Lse. No. Sec. T. R.

FORM 513 REV. SUNRAY

County McPherson Elev. 1548

Sec. 34 Twp. 19 Rge. 2W

Company J. A. Allison

Farm Name Koehn "B" No. 2

TOPS	DEPTH	LOG	DATUM
Anh.			
Tp.			
H.			
Tr.			
Dg.			
B.L.			
L.			
K.C.			
B.K.C.			
Ce.			
C.			
M.	2938		1390
M.			
K.			
Mz.			
Mc.			
V.			
S.			
S.			
A			
R.			
P€.			
G.			
T.D.	2968		

Loc. in Sec. SW SE NE

Geol.

Contr. Cappitt

Pool

COMPLETED

APR 4 '56

Date Comm. 3-17-56

8" @ 164/125 5½" @ 2953 CO to 2968

750 A SP 2947 24/ 2940-46

CO Comp. 35 bopd

Co. Lse. No. Sec. T. R.