

Section 34 Township 19 Range 2W

Well No. #3 Koehn

Company John Darrah

NORTH

			0				

WEST

EAST

SOUTH

SEC.	TWP.	R.
34	19	2W

WELL NO. #3 Koehn FARM

COMPANY John Darrah

CONTRACTOR Barnett


Lively Pool

330 Ft. from N. Line

Ft. from S. Line

330 Ft. from E. Line

Ft. from W. Line

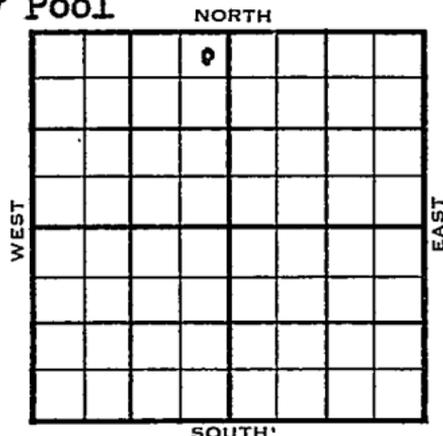

NE NE NW

1954	ELEVATION 1539'	REPORT
------	--------------------	--------

9/1 Spud 8-28-54

8" @ 166'

Drlg. 1875'

11/3 Spud 8-28-54

Oil Well

TD 3140'

8" @ 166'

KC 2316', EroMiss 2938',

TD 3140'

5" @ 3140'

Miss 2942'

30/ 2943-48 FU 1500' fluid 500 A S/ 5

bo 3 bwph 12 hr. P/ 48 bo 50 bwpd.

Comp 53 bopd. /30% Wtr.

**COMPLETED**



County McPherson State Kansas

Sec. 34 (Blk.) 19 (Sur. Rge.) 2W Map No.

Operator John Darrah

Well No. 3 Farm Koehn

Elev. 1539 Location NE NE NW

		0			

330 Ft. From N Line NW

330 Ft. From E Line Quarter

Ist. Report

Completion NOV 3 1954

Remarks Lively Pool

Barnett - Contr.

Spudding Date 8-28-54

Drig. Data Oil well TD 3140

8" @ 166 KC 2316 EroMiss 2938

TD 3140 5" @ 3140 Miss. 2942 30/ 2943-

48 FU 1500' fluid 500 A S/ 5 bo

3 bwph 12 hr. P/ 48 bo 50 bwpd

Comp. 53 bopd 30% wtr.

FABEN GILSTRAP