


Section 34 Township 19 Range 2W

Well No. #1 Koehn

Company Allison

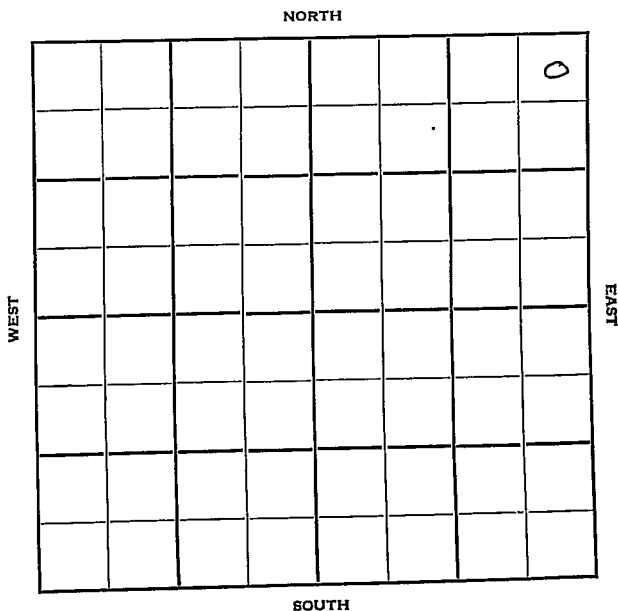

McPherson

KANSAS

Sec. 34 Twp. 19 R. 2W ✓

Well No. #1 Koehn Farm

Allison

Company

Ritz-Canton


330' Ft. from N. Line

Ft. from S. Line

330' Ft. from E. Line

Ft. from W. Line

NE NE NE

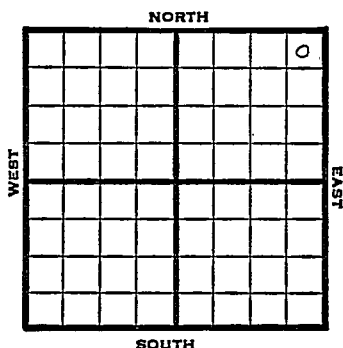

1950

Elev 1551'

R E P O R T

1/18

Spud 1-17-50
Drlg.

2/15

TD 2963'
8" @ 155'
5" @ 2947'
Miss 2962'
35 BOPD
Comp

COMPLETED

Kansas

Ritz-Canton

Map No. _____ Sec. 34 Twp. 19 R. 2WWell No. 1 Koehn

_____ Allison _____ Company

_____ Contractor

NE NE NE

SECTION FLAT

330 Ft. from N. Line

_____ Ft. from S. Line

330 Ft. from E. Line

_____ Ft. from W. Line

			o
FIRST REPORT			

McPherson County

Location _____

Rig up _____

Drilling and Remarks:

Spud 1-18-50

drlg.

RECORD

Cased _____ in., _____ ft.

Sand _____

Gas _____

Oil _____

Total Depth _____

PRODUCTION

1st 24 hrs. Nat. _____

1st 24 hrs. after shot _____

Gas _____ Cu. Ft.

Dry Hole _____

Abandoned _____

Date

JAN 18 1950 19 J. E. TYRA Scout

Map No. _____ Sec. 34 Twp. 19 R. 2W

Well No. 1 Koehn

Allison

Company

Contractor

NE NE NE

E. 1551
SECTION PLAT


330 Ft. from N. Line

_____ Ft. from S. Line

330 Ft. from E. Line

_____ Ft. from W. Line

McPherson County

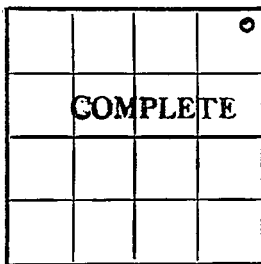

Location _____

Rig up _____

Drilling and Remarks:

8" @ 155

5" @ 2947

run 2962

35 BOPD

RECORD

Cased _____ in., _____ ft.

Sand _____

Gas _____

Oil _____

Total Depth *2963*

PRODUCTION

1st 24 hrs. Nat. _____

1st 24 hrs. after shot _____

Gas _____ Cu. Ft.

Dry Hole _____

Abandoned _____

Date

FEB 15 1950

19

J. E. TYRA

Scout