

McPherson

KANSAS

SECTION 31 TOWNSHIP 19 RANGE 2 WWELL NO. #1 SteinbeckCOMPANY Geo. Hess

NORTH

WEST								EAST
SOUTH								

SOUTH

McPherson

KANSAS

SEC.	TWP.	R.
34	19	2W

WELL NO.

#1 Steinbeck

FARM

COMPANY

Geo Hess

CONTRACTOR

Ritz-Canton


_____ Ft. from N. Line

_____ Ft. from S. Line

_____ Ft. from E. Line

_____ Ft. from W. Line

SE NE SE

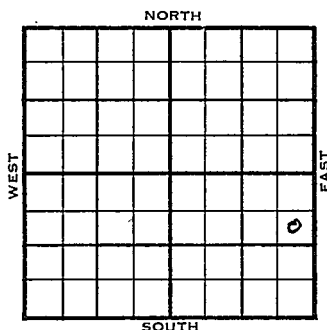

1955	ELEVATION 1541'	REPORT
------	--------------------	--------

10/26 Loc

11-16

Comm. 10-26-55
 8 5/8" @ 157/90
 5 1/2" @ 2938
 CO to TD
 4 bo, Comp. 35 bopd
 TD 2950'
 Tops: K.C. 2303
 M. 2930'

COMPLETED

County **McPherson** Elev. _____
 Sec. **34** Twp. **19** Rge. **2W**
 Company **Geo. Hess**
 Farm Name **Steinbeck** No. **1**

TOPS	DEPTH	LOG	DATUM	Loc. in Sec.
Anh.				SE NE SE
Tp.				
H.				
Tr.				
Dg.				
Bl.				
L.				Geol. _____
K.C.				Contr. _____
B.K.C.				
Ce.				
C.				Pool _____
M.				Ritz-Canton
M.				
K.				
Mz.				
Mo.				
V.				
S.				
S.				
A.				
R.				
Pe.				
G.				
T.D.				

FIRST REPORT
OCT 26 '55

Date Comm. _____
 Location _____

Co.

Lse.

No.

Sec.

T.

R.

County McPherson Elev. 1541
 Sec. 31 Twp. 19 Rge. 2W
 Company Geo. Hess
 Farm Name Steinbeck No. 1

TOPS	DEPTH	LOG	DATUM	Loc. in Sec.
Anh.				SE NE SE
Tr.				
H.				
Tr.				
Dg.				
Bl.				
L.				
K.C.	2303		762	Geol.
B.K.C.				Contr.
Ce.				
C.				
M.	2930		1389	Pool
M.				Ritz-Canton
K.				
Mz.				
Me.				
V.				
S.				
S.				
A.				
R.				
Pe.				
G.				
TD.	2950			

COMPLETE

Date Comm. 10-26-55 NOV 16 1955

8 5/8" @ 157/90 " 5 1/8" @ 2938

CO to TD 4 bo Comp. 35 bopd