


Section 34 Township 19 Range 9W

Well No. #2 Sledd Farm Corp.

Company Lebsack et al

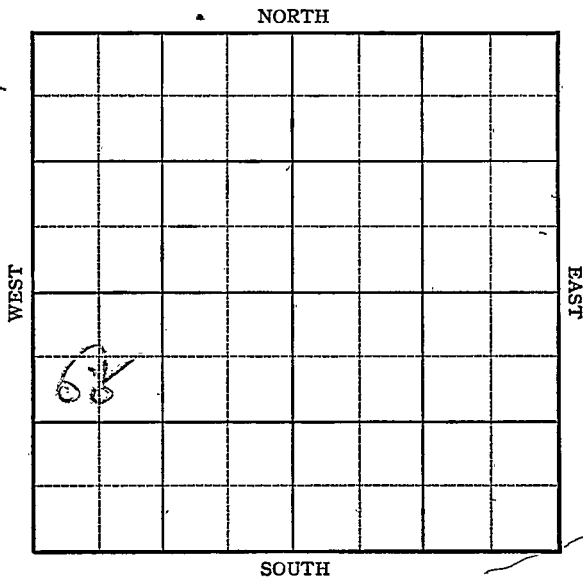

Sec. 34 Twp. 19 R. 9W

Well No. #2 Sledd Farm Corp. Farm

Lebsack et al Company


Chase

990 Ft. from N. Line

\_\_\_\_\_ Ft. from S. Line

\_\_\_\_\_ Ft. from E. Line

660  
330 Ft. from W. Line

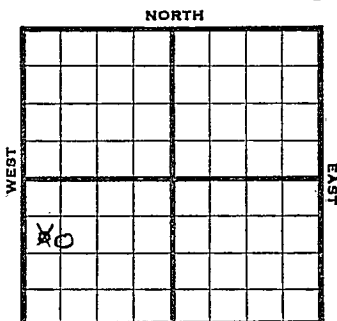

SW NW SW Elev. 1683

1945 REPORT

- 3/14 Rotary
- 3/23 "
- 3/29 10" @ 198  
Drlg. 270
- 4/5 Anhy 305.  
Drilling 2720.
- 4/12 Lans 2852  
Arb 3193  
TD 3202  
5" @ 3200' RUST
- 4/20 500 acid No oil  
TD 3229'
- 4/27 TD 3237 water.  
PB 3225' WOC
- 5/3 " " " "
- 5/10 " " " "
- 5/17 " " " "
- 5/24 " " " "
- 6/6 Arb 3200  
5" @ 3200  
TD 3237'

**ABANDONED**

Pool Name ChaseMap No. 40 Sec. 34 Twp. 19 R. 9WWell No. 2 Sleds Farm Corp.Lebsack etal

Company

## FIRST REPORT

Contractor

SW NW SW

## SECTION PLAT

990 Ft. from N. Line

\_\_\_\_\_ Ft. from S. Line

\_\_\_\_\_ Ft. from E. Line

330 Ft. from W. Line


**Rice**

Location \_\_\_\_\_

Rig up \_\_\_\_\_

Drilling and Remarks:  
**rotary**

## RECORD

Cased \_\_\_\_\_ in., \_\_\_\_\_ ft.

Sand \_\_\_\_\_

Gas \_\_\_\_\_

Oil \_\_\_\_\_

Total Depth \_\_\_\_\_

## PRODUCTION

1st 24 hrs. Nat. \_\_\_\_\_

1st 24 hrs. after shot \_\_\_\_\_

Gas \_\_\_\_\_ Cu. Ft.

Dry Hole \_\_\_\_\_

Abandoned \_\_\_\_\_

Date

MAR 14 1945 19

S. J. LEWIS

Scout

Pool Name ChaseMap No. 19 Sec. 34 Twp. 19 R. 9WWell No. 2 Sledd Farm Corp.Lebsack etal

Company

CORRECTION

Contractor

C S I NW SW

## SECTION PLAT

990 Ft. from N. Line

\_\_\_\_\_ Ft. from S. Line

\_\_\_\_\_ Ft. from E. Line

660 Ft. from W. Line


Rice County

Location \_\_\_\_\_

Rig up \_\_\_\_\_

Drilling and Remarks:

reported  
SW NW SW

## RECORD

Cased \_\_\_\_\_ in., \_\_\_\_\_ ft.

Sand \_\_\_\_\_

Gas \_\_\_\_\_

Oil \_\_\_\_\_

Total Depth \_\_\_\_\_

## PRODUCTION

1st 24 hrs. Nat. \_\_\_\_\_

1st 24 hrs. after shot \_\_\_\_\_

Gas \_\_\_\_\_ Cu. Ft.

Dry Hole \_\_\_\_\_

Abandoned \_\_\_\_\_

Date

MAR 21 1945

19

S. J. LEWIS Scout

Kansas Pool Name Chase

Map No. 49 Sec. 34 Twp. 19 R. 9W

Well No. 2 Sledd Farm Cor p.

Lebsack etal Company

**ABANDONED**

Contractor

C S L NW SW

*E 11683*  
SECTION PLAT

990 Ft. from N. Line

\_\_\_\_\_ Ft. from S. Line

660 Ft. from E. Line

\_\_\_\_\_ Ft. from W. Line

o			

Rice County

Location \_\_\_\_\_

Rig up \_\_\_\_\_

Drilling and Remarks:

*Per 83200*

*5" @ 3200*

**RECORD**

Cased \_\_\_\_\_ in., \_\_\_\_\_ ft.

Sand \_\_\_\_\_

Gas \_\_\_\_\_

Oil \_\_\_\_\_

Total Depth 3237

**PRODUCTION**

1st 24 hrs. Nat. \_\_\_\_\_

1st 24 hrs. after shot \_\_\_\_\_

Gas \_\_\_\_\_ Cu. Ft.

Dry Hole \_\_\_\_\_

Abandoned \_\_\_\_\_

Date

JUN 6 1945 19 \_\_\_\_\_

S. J. LEWIS

Scout