

Section 34 Township 19 Range 13W

Well No. #1 Dorfshaffer

Company Alpine Oil & Royalty etal

NORTH

WEST

EAST

							0

SOUTH

8

Sec. 34 Twp. 19 R. 13W

Well No. #1 Dorfshaffer Farm

Alpine Oil & Royalty et al Company

Quaker Contr. Contractor  
Wildcat


Ft. from N. Line

330' Ft. from S. Line

330' Ft. from E. Line

Ft. from W. Line

SE SE NE

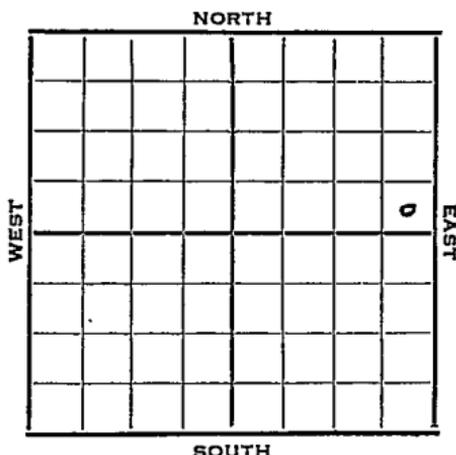

1951

Elev. 1841' REPORT

11/28

Spud 11-26-51  
8" @ 182  
WOC

1952  
1/9

Spud 11-26-51  
Oil Well TD 3463  
8" @ 182  
Anhy 700 Heeb. 3155  
Br Lime 3158 Lans. 3171  
DST 3178-3245 opn 1/2 hr  
Rec. 90' gcm 720' ho & gcm  
Cong. 3414 Arb. 3438-43  
5" @ 3440 TD 3463 1 1/2 mcfg PB 3400  
48/3326-40 500 A wtr PB 3320  
24/3306-12 wtr PB 3256 24/3234-44  
1 1/2 goph 500 A S/8 boph  
Comp. 28 bopd 71% wtr.

**COMPLETED**

**O.W.W.O.**

1952  
1/30

Lans. 3174' Cong. 3414' Arb. 3438'  
5" @ 3440 OTD 3463' PB 3256'  
24/3234-44 500 A 28 BO plus 71% wtr.  
PB 3234' 24/3224-30 NS PB 3215'  
24/3196-3202 1/2 gal oil 30 min.  
24/3188-94 500 A S/4 1/2 BO 1 hr.  
PB 3184 24/3170-76 NS 12/3177-80  
50 A S/2 BO plus 5 BWPB 20/3170-80  
500 A NS CO to 3230' 500 A

**OVER**

1952

1/30

(Information continued)

3224-30 CO 3257' POP no  
increase. P/28 BO plus 71% wtr.  
Comp.

**FIRST REPORT**  
✓  
**COMPLETED**

County **Barton** State **Kansas**

Sec. **34** (Blk. Twp.) **19** (Sur. Rge.) **13W** Map No.

Operator **Alpine Oil & Royalty etal.**

Well No. **1** Farm **Dorfshoffer**

Elev. Location **SE SE NE**



**330** Ft. From **S** Line **NE**

**330** Ft. From **E** Line Quarter

Ist. Report **NOV 28 1951**

Completion

Remarks

**Quaker - Contr.**

Spudding Date **11-26-51**

Drlg. Data **Wildcat**

**8" @ 182 W.O.C.**

**J. E. TYRA**


County Barton State Kansas

Sec. 34 (Blk. Twp.) 19 (Sur. Rge.) 1 3W Map No.

Operator Alpine Oil & Royalty etal.

Well No. 1 Farm Dorfshaffer

Elev. 1841 Location SE SE NE

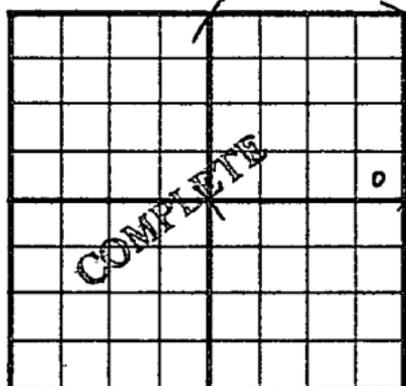

330 Ft. From S Line NE

330 Ft. From E Line Quarter

1st. Report

Completion JAN 9 1952

Remarks Wildcat

Quaker Drlg. - Contr.

Spudding Date 11-26-51

Drlg. Data Oil well. TD 3463

8" @ 182 Anky 700 Heeb. 3155

Br. line 3158 Lans. 3171 DST 3178-3245

open 1/2 hr. Rec. 90' gcm 720' ho & gcm

Cong. 3414 Arb. 3438-43 5" @ 3440

TD 3463 1 1/2 mcfg PB 3400 48/ 3326-40

500 A water PB 3320 24/ 3306-12

water PB 3256 24/ 3234-44 1 1/2 g'oph!

500 A S/ 8 boph Comp. 28 bopd 71% water

J. E. TYRA

