


Section 34 Township 19 Range 13W

Well No. #1 Bartholomew

Company Simon Lebow

*16*

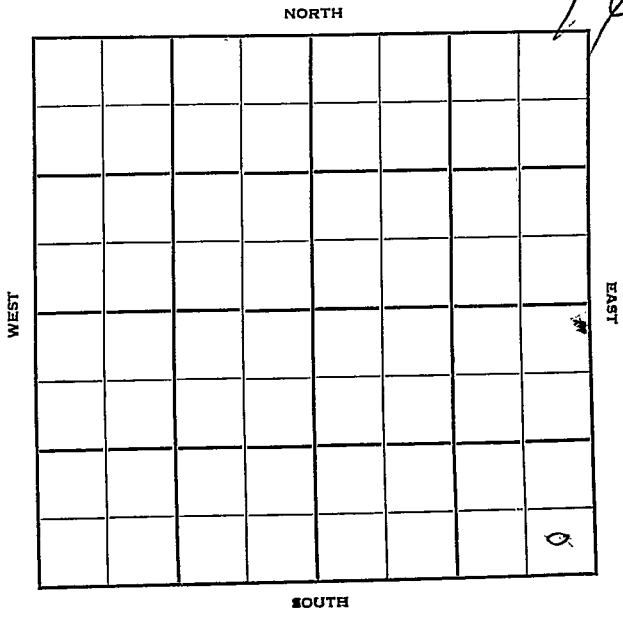

Barton KANSAS

Sec. 34 Twp. 19 R. 13 W

Well No. # 1 Bartholomew Farm

Simon Lebow Company

Quaker Contractor


..... Ft. from N. Line

330 Ft. from S. Line

330 Ft. from E. Line

..... Ft. from W. Line

SE SE SE

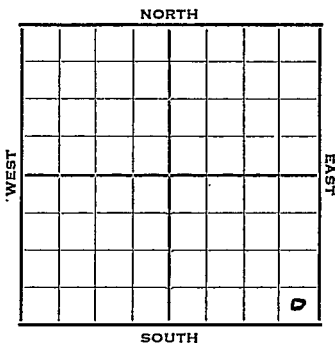

1952 Elev. 1841' REPORT

4/16 MI  
 4/23 8" @ 327  
 Anhy 692  
 Drlg. 2839'  
 4/30 Spud 4-15-52  
 D&A TD 3527 8" @ 327  
 Anhy 692 Heeb. 3068  
 Br Li 3183 Lans. 3196  
 DST 3198-3228 open 1 hr.  
 rec. 15' mud  
 DST 3260-69 open 1/2 hr. rec. 5' mud  
 Cong. 3432' open Arb. 3459  
 DST 3459-65 open 1/2 hr. rec. 12' socm  
 DST 3465-87 open 1/2 hr. rec. 10' socm  
 TD 3527 D&A

**ABANDONED**



