


Section 34 Township 19 Range 13W

Well No. #2 Dorshaffer (A)

Company Alpine Oil & Royalty

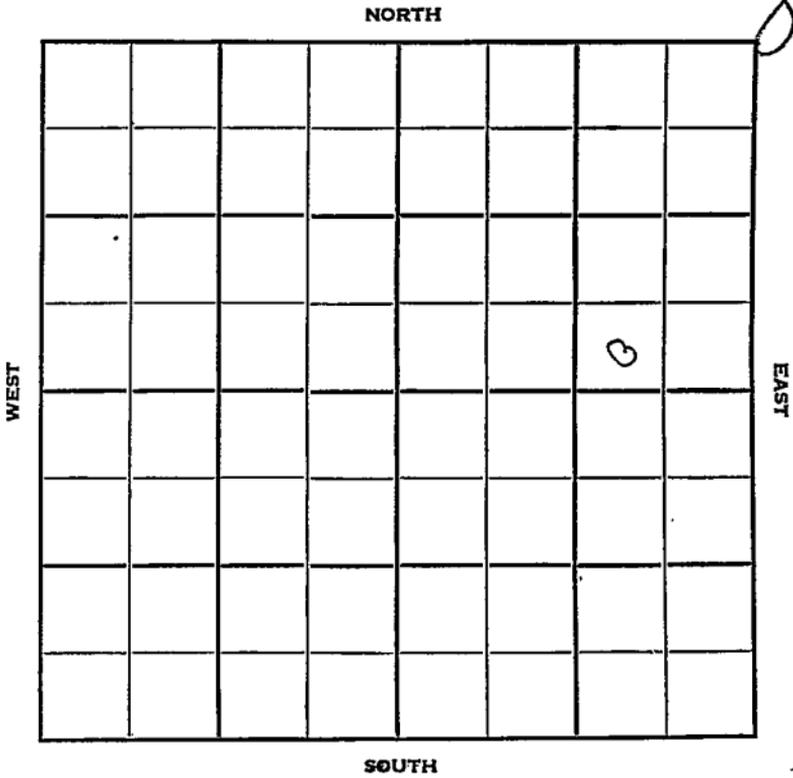

Sec. 34 Twp. 19 R.

Well No. #2 Dorshaffer (A) Farm

Alpine Oil & Royalty Company

Quaker Contractor


Ft. from N. Line

330 Ft. from S. Line

990 Ft. from E. Line

Ft. from W. Line

SW SE NE

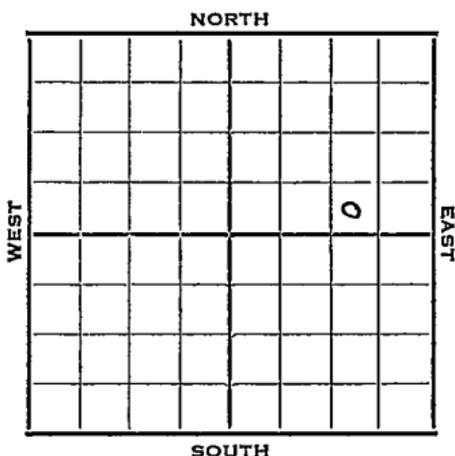

1952

Elev. 1842'

REPORT

6/18

Spud 6-3-52
8" @ 188
Heeb. 3057 Br Li 3170
DST 3185-3221, 1/2 hr. 15'M 1000#
Lans. 3183 DST 3238-60, 1/2 hr.
15' M 120# Cong. 3427
DST 3450-60, 1 hr. 30'M 0#
Arb. 3455 DST 3467-90, 1 hr.
360' gas 120' SO & GCM 10' oil
360# RTD 3490' 5" @ 3467' WOCT

6/25

D.P. .

7/2

DP 3490 B/2 BO & 2 BW 4 hrs.

7/9

PB 3478' 500 A 3455-78 S/1 1/2 BO
plus 10 1/2 BW PB 3459' 28/3446-53' NS
50 A Hyd. S/1 1/2 BO 8 hrs. Fill up
2200' fluid 14 hrs.

7/17

To work over

7/23

NR

7/30

"

8/6

"

8/13

"

8/20

"

8/27

"

9/3

"

9/10

"

OVER

1952

9/17 NR
9/24 "
10/1 "
10/8 "
10/15 "
10/22 "
10/29 "
11/5 "
11/12 Spud 6-3-52
D&A
TD 3490'
8" @ 188',
Heeb 3057, Br. lime 3170'
DST 3185-3221, opn $\frac{1}{2}$ hr., rec.
15' mud, 1000#
Lans 3183
DST 3238-60, opn $\frac{1}{2}$ hr., rec. 15'
mud 120#
Cong. 3427
DST 3450-60, opn 1 hr., rec. 30'
mud 0#
Arb. 3455
DST 3467-90, opn 1 hr., rec. 360'
gas, 120' SO & GCM 10' oil 360#
TD 3490'
5" @ 3467
GO to 3490
B/2 BO 2 BW 4 hrs.
PB 3478' 500A
S/1 $\frac{1}{2}$ BO 10 $\frac{1}{2}$ BW 6 hrs.
PB 3459' 28/3446-53, 50 A Hydro.
S/1 $\frac{1}{2}$ BO 8 hrs., FU 2200' fluid
14 hrs.
D&A

ABANDONED

