
KANSAS Barton

FORM 51 5M PETROL

Section 34 Township 19 Range 12W

Well No. 1 Musenberg

Company W. L. Hartman

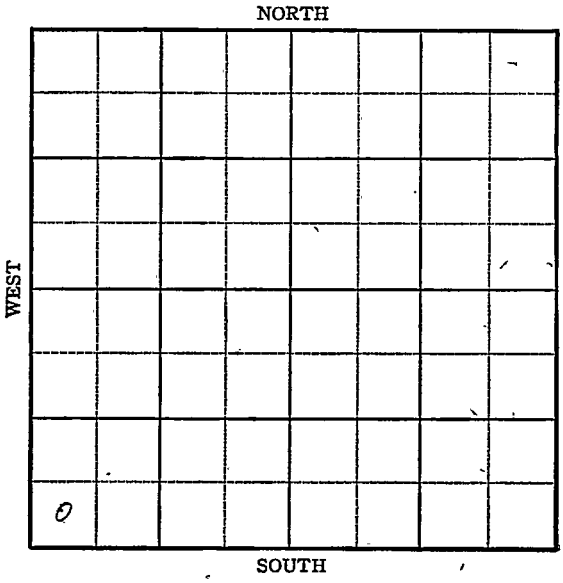

FORM 252-A
5M 8-45 PETROL

KANSAS Barton.

Sec. 34 Twp. 19 R. 12-W

Well No. #1 Musenberg Farm

W. L. Hartman Company


____ Ft. from N. Line

330 Ft. from S. Line

____ Ft. from E. Line

330 Ft. from W. Line

SW/c

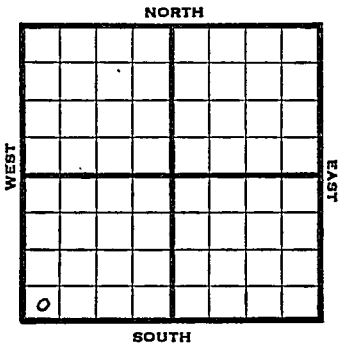

1945	Elev. 1808 REPORT
10/17	Location
10/24	"
10/31	"
11 7	8" @ 224 Anks 610 Drlg. 1485'
11/14	Lans 3138 Arb. 3385-3390 TD 3390' 5" @ 3385 RUST
11/21	" " "
11/28	" " "
12/5	2000 acid. No shows. 71 shots 3385-3390 6 qts. 3385-90 2000 acid.
12/12	TD 3404 1000 acid.
12/19	Arb. 3385 5" @ 3385 TD 3429'

ABANDONED

FORM 26 200 BKS 1-44 PETRO

KANSAS

Kansas Pool Name Hammer

Map No. 46 Sec. 34 Twp. 19 R. 12W


Well No. 1 Mosenberg

W. L. Hartman Company

FIRST REPORT Contractor

SW/c

SECTION PLAT

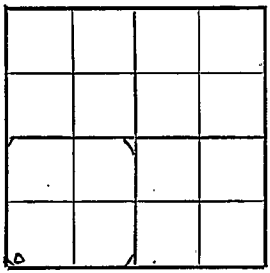

____ Ft. from N. Line

330 Ft. from S. Line

____ Ft. from E. Line

330 Ft. from W. Line

Barton County

Location x

Rig up

Drilling and Remarks:

RECORD

Cased ____ in., ____ ft.

Sand

Gas

Oil

Total Depth

PRODUCTION

1st 24 hrs. Nat.

1st 24 hrs. after shot

Gas ____ Cu. Ft.

Dry Hole

Abandoned

Date

~~OCT~~ 17 1945 19 S. J. LEWIS Scout

FORM 26 200 BKS 1-44 PETROL

KANSAS Kansas Pool Name Hammer

Map No. K-46 Sec. 34 Twp. 19 R. 12W

Well No. 1 Kusenberg


W.L.Hartman Company

ABANDONED Contractor

SW/c

E1,1808.

SECTION PLAT

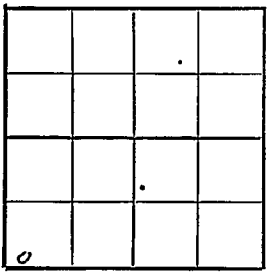

____ Ft. from N. Line

330 Ft. from S. Line

____ Ft. from E. Line

330 Ft. from W. Line

Barton County

Location

Rig up

Drilling and Remarks:

Cr 3385'

5" @ 3385

RECORD

Cased ____ in., ____ ft.

Sand

Gas

Oil

Total Depth 3429

PRODUCTION

1st 24 hrs. Nat.

1st 24 hrs. after shot

Gas ____ Cu. Ft.

Dry Hole

Abandoned

Date

DEC 19 1945 19

S. J. LEWIS Scout