

Section 34 Township 19 Range 12WWell No. #2 SchartzCompany W. L. Hartman

NORTH

0							

SOUTH

4

WEST

EAST

Sec. 34 Twp. Barton 19 R. KANSAS 12W

Well No. #2 Scharitz Farm

W. L. Hartman Company

W. L. Hartman -Contr. Contractor

330' Ft. Zarah Pool

Ft. from N. Line


Ft. from S. Line

Ft. from E. Line

330'

Ft. from W. Line

NW NW NW

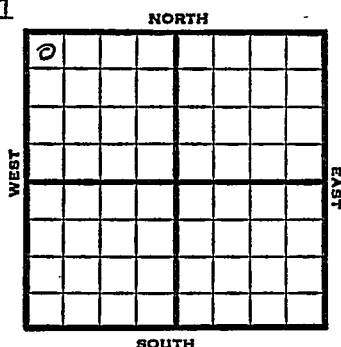

1951

Elev. 1813' REPORT

9/26

Spud 9-18-51

8" @ 90'

Anhy 630

Drlg. 2881'

10/24

Spud 9-18-51

Oil Well TD 3356

8" @ 90

Anhy 630 Top. 2706

DST 2914-28 open $\frac{1}{2}$ hr.

Rec. 75' GCM

Heeb. 2969 Lans. 3102

DST 3103-17 open 6 min.

Rec. 35' GCM

DST 3134-53 open 1 hr.

Rec. 100' HOCM

DST 3256-76 open 26 min.

Rec. 360' HOCM

Arb. 3354-56

5" @ 3354 CO to 3343

20/ 3324-39 500 A

71/ 3166-78 1000 A

Comp. BHB 1271 BOPD

COMPLETED

County Barton State KansasSec. 34 (Blk.) 19 (Sur.) 12W Map No.Operator W. L. HartmanWell No. 2 Farm SchartzElev. Location NW NW NW (twin well 75'

0									

330 Ft. From N Line NW330 Ft. From W Line Quarter1st. Report SEP 26 1951

Completion

Remarks

W. L. Hartman - Contr.Spudding Date 9-18-51Drlg. Data Ft. Zarah - pool8" @ 90' Anhy 630' Drlg. 2881

County Barton State Kansas
 Sec. 34 (Blk. Twp.) 19 (Sur. Rge.) 12W Map No. _____
 Operator W. L. Hartman
 Well No. 2 Farm Schartz
 Elev. 1813 Location NW NW NW (twin well)

0						

COMPLETE

330 Ft. From N Line NW
 330 Ft. From W Line Quarter
 Ist. Report _____
 Completion OCT 24 1951
 Remarks Ft. Zarah Pool
Hartman - Contr.
 Spudding Date 9-18-51

Drlg. Data Oil well TD 3356
8" @ 90 Anhy 630 Top. 2706 DST 2914-28
open $\frac{1}{2}$ hr. Rec. 75' gcm Heeb. 2969
Lans. 3102 DST 3103-17 open 6 min.
Rec. 35' gcm DST 3134-53 open 1 hr.
Rec. 100' hocom DST 3256-76 open 26 min.
Rec. 360' hocom Arb. 3354-56 5" @ 3354
CO to 3343 20/ 3324-30 500 A
71/ 3166-78 1000 A
Comp. BHB 1271 hord