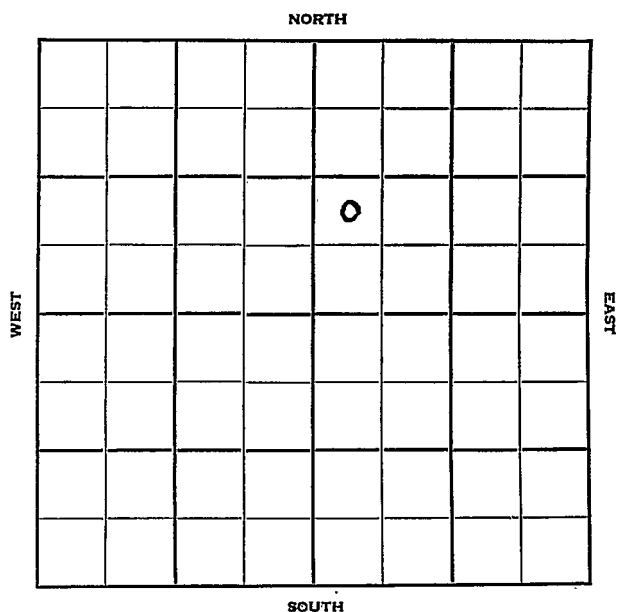


Section 34 Township 19 Range 12 WWell No. # 1 ShartzCompany Francis Raymond

Sec. 34 Twp. 19 R. 12 W

Well No. # 1 Shartz Farm

Francis Raymond Company

Murfin Contractor


 Ft. from N. Line

990 Ft. from S. Line

 Ft. from E. Line

330 Ft. from W. Line

NW SW NE

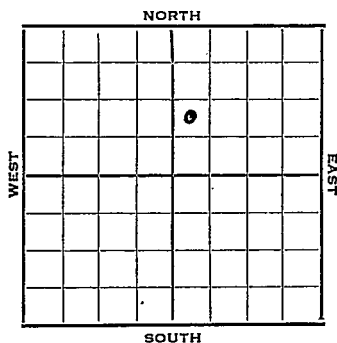

1952

Elev. 1806' REPORT

4/2 Spud 3-31-52
8" @ 130' WOC

4/9 Anhy 597 Heeb. 2970
Drlg. 3085'

4/23 Br Li 3091 Lans. 3105
Arb. 3387
DST 3106-33 38 mins, 11' M O#
DST 3132-55 1 hr, 33' M scum of oil
800#
DST 3155-80 42 mins, 23' M 250#
DST 3219-44 38 mins 6' M O#
DST 3244-77 1 hr. 500' HO&GCM
580' gassy oil 60' SW 1100#
DST 3296-3355 1 hr. 25' fluid
O# Cong. 3355 Arb. 3388
RTD 3396 5" @ 3390
DP CO to 3396 HFW to PB Perf.

4/30 NR

5/7 PB 3373' Perf ?/ 3271-87 wtr.
PB 3257 1/2' Perf ?/ 3244-50'
4.9 BOPH plus 2.1 BWPH POP

5/14 NR

5/21 "

5/28 "

6/11 "

OVER

1952

6/18 Spud 3-31-52
Oil Well TD 3396
8" @ 130 Anhy 597
Heeb. 2970 Br lime 3091
Lans. 3105
DST 3106-33 opn 38 min
Rec. 11' mud DST 3132-55
opn 1 hr. Rec. 33' mud scum of oil
DST 3155-80 opn 42 min. Rec. 23' mud
DST 3219-44 opn 38 min. Rec. 6' mud
DST 3244-77 opn 1 hr. Rec. 500' ho
& gcm 580' gassy oil 60' sw
DST 3296-3355 opn 1 hr. Rec. 25' ~
fluid Cong. 3355 Arb. 3388
5" @ 3390 Co to 3396
HFW PB 3373 Perf 3271-87 wtr
PB 3257 Perf 3244-50 4.9 boph
2.1 bw Comp. 133 bopd 48% wtr.

COMPLETED

County Barton State KansasSec. 34 (Blk.) 19 (Sur.) 12W Map No.Operator Francis RaymondWell No. 1 Farm ShartzElev. Location NW SW NE

FIRST REPORT

990 Ft. From S Line NE330 Ft. From W Line Quarter1st. Report APR 2 1952

Completion

Remarks

Murfin - Contr.Spudding Date 3-31-52

Drlg. Data

8" @ 130 W.O.C.

J. G. McGEHEE

County Barton State KansasSec. 34 (Blk. 19 (Sur. 12W (Twp. Map No.Operator Francis RaymondWell No. 1 Farm ShartzElev. 1806 Location NW SW NE

990 Ft. From S Line NE330 Ft. From W Line Quarter

1st. Report

Completion JUN 1 8 1952

Remarks

Murfin Drlg. - Contr.Spudding Date 3-31-52Drlg. Data Oil well TD 33968" @ 130 Anhy 597 Heeb. 2970Br. lime 3091 Lans. 3105 DST 3106-33open 38 min. Rec. 11' mud DST 3132-55open 1 hr. Rec. 33' mud scum of oilDST 3155-80 open 42 min. Rec. 23' mudDST 3219-44 open 38 min. Rec. 6' mudDST 3244-77 open 1 hr. Rec. 500' ho &gcm 580' gassy oil 60' sw DST 3296-3355 open 1 hr. Rec. 25' fluid Cong.3355 Arb. 3388 TD 3396 5" @ 3390CO to 3396 HFW PB 3373 Perf/ 3271-87water PB 3257 Perf/ 3244-50 4.9 boph2.1 bw Comp. 133 bopd 48% water

J. G. McGEHEE